


1 LOCATION OF WATER WELL: Fraction NW 1/4 NE 1/4 NW 1/4 Section Number 18 Township Number 14 S Range Number 25 E W
 County: Johnson
 Street/Rural Address of Well Location: if unknown, distance & direction from nearest town or intersection: If at owner's address, check here 159th St + Antioch Rd. Overland Park KS
 Global Positioning Systems (GPS) information:
 Latitude: _____ (in decimal degrees)
 Longitude: _____ (in decimal degrees)
 Elevation: _____
 Horizontal Datum: WGS84 NAD83 NAD27
 Collection Method: _____
 GPS unit (Make/Model) _____
 Digital Map/Photo Topographic Map Land Survey
 Est. Accuracy: 3 m. 3-5 m. 5-15 m. >15 m

2 WATER WELL OWNER: Hart Construction Co.
 RR#: St. Address, Box #: 19451 W, 207th St.
 City, State ZIP Code: Spring Hill, KS 66083

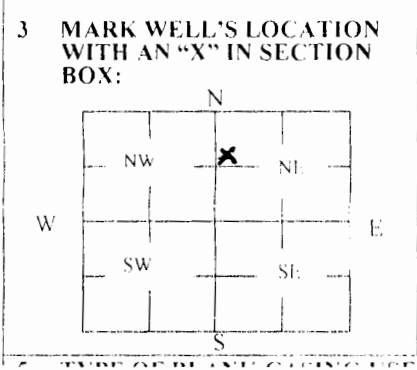

4 DEPTH OF WELL 15 ft.
 WELL'S STATIC WATER LEVEL 10 ft.
 WELL WAS USED AS:
 Domestic Public Water Supply Dewatering
 Irrigation Oil Field Water Supply Monitoring
 Feedlot Domestic (Lawn & Garden) Injection Well
 Industrial Air Conditioning Other _____
 Was a chemical/bacteriological sample submitted to Department? Yes No

5 TYPE OF BLANK CASING USED:
 Steel RMP (SR) Wrought Fiberglass Other (Specify below)
 PVC ABS Asbestos-Cement Concrete Tile Rock + Grout
 Blank casing diameter 96 in. Was casing pulled? Yes No If yes, how much 5 FT
 Casing height above or below land surface 0 in.

6 GROUT PLUG MATERIAL: Neat cement Cement grout Bentonite Other _____
 Grout Plug Intervals: From 5 ft. to 4 1/2 ft. From _____ ft. to _____ ft. From _____ ft. to _____ ft.

What is the nearest source of possible contamination:
 Septic tank Seepage pit Fuel storage Other (specify below)
 Sewer lines Pit privy Fertilizer storage
 Watertight sewer lines Sewage lagoon Insecticide storage
 Lateral lines Feedyard Abandoned water well Direction from well? East
 Cess pool Livestock pens Oil well Gas well How many feet? 200 FT

FROM	TO	PLUGGING MATERIALS	FROM	TO	PLUGGING MATERIALS
15 FT	10 FT	Well Casing material			
10 FT	5 FT	Sand + Gravel			
5 FT	4 1/2 FT	Bentonite			
4 1/2 FT	0 FT	clay			

7 CONTRACTOR'S OR LANDOWNER'S CERTIFICATION: This water well was plugged under my jurisdiction and was completed on (mo/day/year) 2/21/17 and this record is true to the best of my knowledge and belief. Kansas Water Well Contractor's License No. _____ This Water Well Record was completed on (mo/day/year) 2/21/17 under the business name of Hart Construction Co. by (signature) Justin J. Hart

Send one white copy to Kansas Department of Health & Environment, Geology Section, 1000 SW Jackson Street, Ste. 420, Topeka, KS 66612-1367. Send one copy to WATER WELL OWNER and retain one for your records.
 Visit us at <http://www.kdheks.gov/waterwell/index.html> Telephone 785-296-5524.