


1 LOCATION OF WATER WELL: Fraction SW 1/4 Section Number 4 Township Number T 14 S Range Number R 3
 County: Dickinson

Distance and direction from nearest town or city street address of well if located within city?
2 1/2 miles South of Enterprise, Ks. on 43 Hwy

2 WATER WELL OWNER: Margaret Neuschafer
 RR#, St. Address, Box #: Rt. 2 Board of Agriculture, Division of Water Resources
 City, State, ZIP Code: Enterprise, Kansas 67441 Application Number:

3 LOCATE WELL'S LOCATION WITH AN "X" IN SECTION BOX:

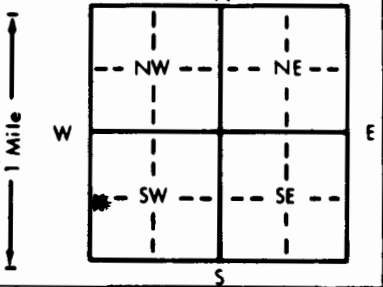

4 DEPTH OF COMPLETED WELL: 88 ft. ELEVATION:
 Depth(s) Groundwater Encountered 1. 74 ft. 2. ft. 3. ft.
 WELL'S STATIC WATER LEVEL: 67 ft. below land surface measured on mo/day/yr 7 / 30 / 86
 Pump test data: Well water was ft. after hours pumping gpm
 Est. Yield 154 gpm: Well water was ft. after hours pumping gpm
 Bore Hole Diameter: 9 in. to 88 ft., and in. to ft.
 WELL WATER TO BE USED AS:
 1 Domestic 3 Feedlot 6 Oil field water supply 9 Dewatering 12 Other (Specify below)
 2 Irrigation 4 Industrial 7 Lawn and garden only 10 Observation well
 Was a chemical/bacteriological sample submitted to Department? Yes no No no; If yes, mo/day/yr sample was submitted
 Water Well Disinfected? Yes no No

5 TYPE OF BLANK CASING USED:
 1 Steel 3 RMP (SR) 5 Wrought iron 8 Concrete tile CASING JOINTS: Glued Clamped
 2 PVC 4 ABS 6 Asbestos-Cement 9 Other (specify below) Welded
 7 Fiberglass Threaded

Blank casing diameter: 5 in. to 88 ft., Dia. in. to ft., Dia. in. to ft.
 Casing height above land surface: 16 in., weight 160 lbs./ft. Wall thickness or gauge No. 214

TYPE OF SCREEN OR PERFORATION MATERIAL:
 1 Steel 3 Stainless steel 5 Fiberglass 7 PVC 10 Asbestos-cement
 2 Brass 4 Galvanized steel 6 Concrete tile 8 RMP (SR) 11 Other (specify)
 12 None used (open hole)

SCREEN OR PERFORATION OPENINGS ARE:
 1 Continuous slot 3 Mill slot 5 Gauzed wrapped 8 Saw cut 11 None (open hole)
 2 Louvered shutter 4 Key punched 6 Wire wrapped 9 Drilled holes
 7 Torch cut 10 Other (specify)

SCREEN-PERFORATED INTERVALS: From 68 ft. to 88 ft., From ft. to ft.
 From ft. to ft., From ft. to ft.
 GRAVEL PACK INTERVALS: From 15 ft. to 88 ft., From ft. to ft.
 From ft. to ft., From ft. to ft.

6 GROUT MATERIAL: 1 Neat cement 2 Cement grout 3 Bentonite 4 Other
 Grout Intervals: From 4 ft. to 15 ft., From ft. to ft., From ft. to ft.

What is the nearest source of possible contamination:
 1 Septic tank 4 Lateral lines 7 Pit privy 10 Livestock pens 14 Abandoned water well
 2 Sewer lines 5 Cess pool 8 Sewage lagoon 11 Fuel storage 15 Oil well/Gas well
 3 Watertight sewer lines 6 Seepage pit 9 Feedyard 12 Fertilizer storage 16 Other (specify below)
 13 Insecticide storage
 Direction from well? NORTHWEST How many feet? 26

FROM	TO	LITHOLOGIC LOG	FROM	TO	LITHOLOGIC LOG
0	1	DARK TOP SOIL			
1	9	LITE BROWN CLAY & SHALE			
9	16	RED COLOR CLAY & SHALE			
16	19	RED CLAY & SHALE			
19	29	LITE COLOR CLAY & SHALE			
29	34	LIMESTONE			
34	36	LITE COLOR SHALE & LIMESTONE			
36	57	GRAY CLAY & SHALE			
57	64	RED SHALE			
64	68	GRAY SHALE			
68	69	GYPSUM ROCK			
69	70	CAVITY			
70	88	LIMESTONE & FLINT			
88		DARK SHALE			

7 CONTRACTOR'S OR LANDOWNER'S CERTIFICATION: This water well was (1) constructed, (2) reconstructed, or (3) plugged under my jurisdiction and was completed on (mo/day/year) 7 / 30 / 86 and this record is true to the best of my knowledge and belief. Kansas Water Well Contractor's License No. 397 This Water Well Record was completed on (mo/day/yr) 2 / 19 / 87 under the business name of CENTRAL KANSAS DRILLING by (signature) Harold D. Marten

INSTRUCTIONS: Use typewriter or ball point pen. PLEASE PRESS FIRMLY and PRINT clearly. Please fill in blanks, underline or circle the correct answers. Send top three copies to Kansas Department of Health and Environment, Office of Oil Field and Environmental Geology, Regulation and Permitting Section, Topeka, Kansas 66620-7500, Telephone: 913-862-9360. Send one to WATER WELL OWNER and retain one for your records.