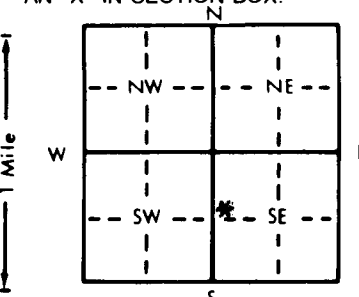


1 LOCATION OF WATER WELL: Fraction SE 1/4 NW 1/4 SE 1/4 Section Number 4 Township Number T 14 S Range Number R 3 E\*\*  
 County: Dickinson

Distance and direction from nearest town or city street address of well if located within city?  
3 miles South of Enterprise, Ks & 2/3 mile East & 1/4 North

2 WATER WELL OWNER: Ben Neuschafer Board of Agriculture, Division of Water Resources  
 RR#, St. Address, Box # : Rt 1, Box 63 Application Number:  
 City, State, ZIP Code : Enterprise, Kansas 67441

3 LOCATE WELL'S LOCATION WITH AN "X" IN SECTION BOX:  


4 DEPTH OF COMPLETED WELL: 72 ft. ELEVATION:  
 Depth(s) Groundwater Encountered 1. 42 ft. 2. ft. 3. ft.  
 WELL'S STATIC WATER LEVEL 38 ft. below land surface measured on mo/day/yr 2 / 18 / 91  
 Pump test data: Well water was ft. after hours pumping gpm  
 Est. Yield 5-6 gpm: Well water was ft. after hours pumping gpm  
 Bore Hole Diameter 9 in. to 72 ft., and in. to ft.  
 WELL WATER TO BE USED AS: 5 Public water supply 8 Air conditioning 11 Injection well  
 1 Domestic 3 Feedlot 6 Oil field water supply 9 Dewatering 12 Other (Specify below)  
 2 Irrigation 4 Industrial 7 Lawn and garden only 10 Monitoring well  
 Was a chemical/bacteriological sample submitted to Department? Yes No \*; If yes, mo/day/yr sample was submitted  
 Water Well Disinfected? Yes \* No

5 TYPE OF BLANK CASING USED:  
 1 Steel 3 RMP (SR) 5 Wrought iron 8 Concrete tile CASING JOINTS: Glued \* Clamped  
 2 PVC 4 ABS 6 Asbestos-Cement 9 Other (specify below) Welded  
 7 Fiberglass Threaded  
 Blank casing diameter 5 in. to 72 ft., Dia in. to ft., Dia in. to ft.  
 Casing height above land surface 16 in., weight 160 lbs./ft. Wall thickness or gauge No. 214  
 TYPE OF SCREEN OR PERFORATION MATERIAL:  
 1 Steel 3 Stainless steel 5 Fiberglass 7 PVC 10 Asbestos-cement  
 2 Brass 4 Galvanized steel 6 Concrete tile 8 RMP (SR) 11 Other (specify)  
 9 ABS 12 None used (open hole)  
 SCREEN OR PERFORATION OPENINGS ARE:  
 1 Continuous slot 3 Mill slot 5 Gauzed wrapped 8 Saw cut 11 None (open hole)  
 2 Louvered shutter 4 Key punched 6 Wire wrapped 9 Drilled holes  
 7 Torch cut 10 Other (specify)  
 SCREEN-PERFORATED INTERVALS: From 38 ft. to 72 ft., From ft. to ft.  
 From ft. to ft., From ft. to ft.  
 GRAVEL PACK INTERVALS: From 23 ft. to 72 ft., From ft. to ft.  
 From ft. to ft., From ft. to ft.

6 GROUT MATERIAL: 1 Neat cement 2 Cement grout 3 Bentonite 4 Other  
 Grout Intervals: From 3 ft. to 23 ft., From ft. to ft., From ft. to ft.  
 What is the nearest source of possible contamination:  
 1 Septic tank 4 Lateral lines 7 Pit privy 10 Livestock pens 14 Abandoned water well  
 2 Sewer lines 5 Cess pool 8 Sewage lagoon 11 Fuel storage 15 Oil well/Gas well  
 3 Watertight sewer lines 6 Seepage pit 9 Feedyard 12 Fertilizer storage 16 Other (specify below)  
 13 Insecticide storage  
 Direction from well? SOUTH How many feet? 55

FROM	TO	LITHOLOGIC LOG	FROM	TO	PLUGGING INTERVALS
0	3	DARK TOP SOIL			
3	4	SOFT LITE COLOR LIMESTONE			
4	9	LITE COLOR SHALEY CLAY			
9	19	LITE CLAY & MIXED WITH BROWN CLAY			
19	22	RED CLAY			
22	36	LITE COLOR CLAY & SHALE			
36	39	HARD LITE COLOR LIMESTONE			
39	40	LITE COLOR CLAY			
40	42	HARD LITE CILIR LIMESTONE			
42	56	GRAY SHALE			
56	58	HARD LITE COLOR LIMESTONE			
58	60	LITE COLOR SHALE			
60	63	LITE & RED SHALE MIXED			
63	72	RED CLAY & SHALE			
<del>75</del>		<del>LITE GRAY CLAY &amp; SHALE</del>			

7 CONTRACTOR'S OR LANDOWNER'S CERTIFICATION: This water well was (1) constructed, (2) reconstructed, or (3) plugged under my jurisdiction and was completed on (mo/day/year) 2 / 18 / 91 and this record is true to the best of my knowledge and belief. Kansas Water Well Contractor's License No. 397 This Water Well Record was completed on (mo/day/yr) 2 / 26 / 91 under the business name of CENTRAL KANSAS DRILLING by (signature) Harold D. Martin

22-900120187

OFFICE USE ONLY  
T  
R  
EW  
SEC.  
1/4  
1/4  
1/4