


1 LOCATION OF WATER WELL: Fraction Se 1/4 Se 1/4 NW 1/4 Section Number 12 Township Number T 14 S Range Number R 3 E
 County: Dickinson

Distance and direction from nearest town or city street address of well if located within city?
4 N 3 1/2 E Navarre

2 WATER WELL OWNER: Pearl COOP
 RR#, St. Address, Box #: RBI Board of Agriculture, Division of Water Resources
 City, State, ZIP Code: Chapman, KS. 67431 Application Number:

3 LOCATE WELL'S LOCATION WITH AN "X" IN SECTION BOX:

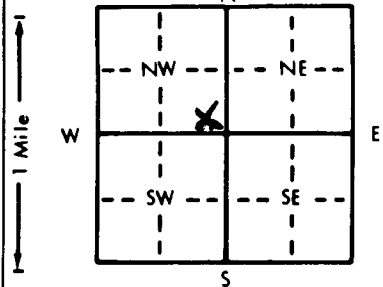

4 DEPTH OF COMPLETED WELL: 132 ft. ELEVATION:
 Depth(s) Groundwater Encountered 1 89 123 ft. 2. ft. 3.
 WELL'S STATIC WATER LEVEL 89 ft. below land surface measured on mo/day/yr 5-1-91
 Pump test data: Well water was _____ ft. after _____ hours pumping _____ gpm
 Est. Yield 30 gpm: Well water was _____ ft. after _____ hours pumping _____ gpm
 Bore Hole Diameter: 2 1/2 in. to 132 ft., and _____ in. to _____ ft.
 WELL WATER TO BE USED AS:
 1 Domestic 1 3 Feedlot 3 6 Oil field water supply 6 9 Dewatering 9 11 Injection well
 2 Irrigation 2 4 Industrial 4 7 Lawn and garden only 7 10 Monitoring well 10 12 Other (Specify below)
 Was a chemical/bacteriological sample submitted to Department? Yes _____ No X; If yes, mo/day/yr sample was submitted
 Water Well Disinfected? Yes X No

5 TYPE OF BLANK CASING USED:
 1 Steel 1 3 RMP (SR) 3 6 Asbestos-Cement 6 9 Other (specify below) _____
 2 PVC 2 4 ABS 4 7 Fiberglass _____
 Blank casing diameter 5 in. to 105 ft. Dia _____ in. to _____ ft. Dia _____ in. to _____ ft.
 Casing height above land surface 15 in. weight CLASS 160 lbs./ft. Wall thickness or gauge No. 214

TYPE OF SCREEN OR PERFORATION MATERIAL:
 1 Steel 1 3 Stainless steel 3 5 Fiberglass 5 8 RMP (SR) 8 10 Asbestos-cement
 2 Brass 2 4 Galvanized steel 4 6 Concrete tile 6 9 ABS 9 11 Other (specify) _____
 12 None used (open hole)

SCREEN OR PERFORATION OPENINGS ARE:
 1 Continuous slot 1 3 Mill slot 3 5 Gauzed wrapped 5 8 Saw cut 8 11 None (open hole)
 2 Louvered shutter 2 4 Key punched 4 6 Wire wrapped 6 9 Drilled holes 9
 7 Torch cut 7 10 Other (specify) _____

SCREEN-PERFORATED INTERVALS: From 105 ft. to 132 ft., From _____ ft. to _____ ft.
 From _____ ft. to _____ ft., From _____ ft. to _____ ft.
 GRAVEL PACK INTERVALS: From 25 ft. to 132 ft., From _____ ft. to _____ ft.
 From _____ ft. to _____ ft., From _____ ft. to _____ ft.

6 GROUT MATERIAL: 1 Neat cement 2 Cement grout 3 Bentonite 4 Other _____
 Grout intervals: From 0 ft. to 25 ft., From _____ ft. to _____ ft., From _____ ft. to _____ ft.

What is the nearest source of possible contamination:
 1 Septic tank 1 4 Lateral lines 4 7 Pit privy 7 10 Livestock pens 10 14 Abandoned water well
 2 Sewer lines 2 5 Cess pool 5 8 Sewage lagoon 8 11 Fuel storage 11 15 Oil well/Gas well
 3 Watertight sewer lines 3 6 Seepage pit 6 9 Feedyard 9 12 Fertilizer storage 12 16 Other (specify below)
 13 Insecticide storage 13
 Direction from well? E How many feet? 80'

FROM	TO	LITHOLOGIC LOG	FROM	TO	PLUGGING INTERVALS
0	17	Yellow Clay			
17	32	Red Shale			
32	39	lime			
39	50	Yellow Clay			
50	73	Blue Shale			
73	90	Red Shale			
90	105	lime			
105	123	lime & Gray Rock Mixed			
123	124	Water			
124	132	Gray Rock			

7 CONTRACTOR'S OR LANDOWNER'S CERTIFICATION: This water well was (1) constructed, (2) reconstructed, or (3) plugged under my jurisdiction and was completed on (mo/day/year) 5-1-91 and this record is true to the best of my knowledge and belief. Kansas Water Well Contractor's License No. 180 This Water Well Record was completed on (mo/day/yr) 5-1-91 under the business name of Bachve Drilling by (signature) Paul Bachve