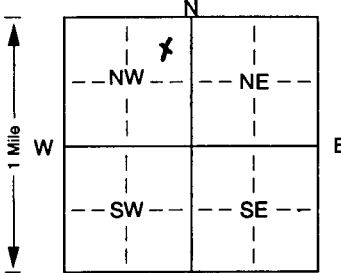


1 LOCATION OF WATER WELL: Fraction Section Number Township Number Range Number  
 County: Dickinson NE 1/4 NE 1/4 NW 1/4 33 T 14 S R 3 **EW**

Distance and direction from nearest town or city street address of well if located within city?  
 50' North of May street on the West side of Second street-----Navarre, Kansas

2 WATER WELL OWNER: USDA/CCC Farm Credit Service ~~(MW-1)~~  
 RR#, St. Address, Box # : 1400 Independence Ave, SW, Room 4723, Stop 0513 Board of Agriculture, Division of Water Resources  
 City, State, ZIP Code : Washington, DC 20250-0513 Application Number:

3 LOCATE WELL'S LOCATION WITH AN "X" IN SECTION BOX:  
  
 4 DEPTH OF COMPLETED WELL: 59 ft. ELEVATION: 1,344'  
 Depth(s) Groundwater Encountered 1. 43.7 ft. 2. ft. 3. ft.  
 WELL'S STATIC WATER LEVEL ... 31.4 ft. below land surface measured on mo/day/yr ~~02/20/93~~ 4/2/93  
 Pump test data: Well water was ft. after hours pumping gpm  
 Est. Yield gpm: Well water was ft. after hours pumping gpm  
 Bore Hole Diameter. 8 in. to 59 ft., and in. to ft.  
 WELL WATER TO BE USED AS: 5 Public water supply 8 Air conditioning 11 Injection well  
 1 Domestic 3 Feedlot 6 Oil field water supply 9 Dewatering 12 Other (Specify below)  
 2 Irrigation 4 Industrial 7 Domestic (lawn & garden) 10 Monitoring well  
 Was a chemical/bacteriological sample submitted to Department? Yes. No. **XX**; If yes, mo/day/yrs sample was submitted Water Well Disinfected? Yes No **XX**

5 TYPE OF BLANK CASING USED: 5 Wrought iron 8 Concrete tile CASING JOINTS: Glued. Clamped.  
 1 Steel 3 RMP (SR) 6 Asbestos-Cement 9 Other (specify below) Welded  
 2 PVC 4 ABS 7 Fiberglass Threaded  
 Blank casing diameter 2 in. to 43 in. Dia. in. to ft. Dia. in. to ft.  
 Casing height above land surface 18 in., weight Sch. 40 lbs./ft. Wall thickness or gauge No.  
 TYPE OF SCREEN OR PERFORATION MATERIAL: 7 PVC 10 Asbestos-cement  
 1 Steel 3 Stainless steel 5 Fiberglass 8 RMP (SR) 11 Other (specify)  
 2 Brass 4 Galvanized steel 6 Concrete tile 9 ABS 12 None used (open hole)  
 SCREEN OR PERFORATION OPENINGS ARE: 5 Gauzed wrapped 8 Saw cut 11 None (open hole)  
 1 Continuous slot 3 Mill slot 6 Wire wrapped 9 Drilled holes  
 2 Louvered shutter 4 Key punched 7 Torch cut 10 Other (specify) ft.  
 SCREEN-PERFORATED INTERVALS: From 43 ft. to 58 ft., From ft. to ft.  
 From ft. to ft., From ft. to ft.  
 GRAVEL PACK INTERVALS: From 40 ft. to 59 ft., From ft. to ft.  
 From ft. to ft., From ft. to ft.

6 GROUT MATERIAL: 1 Neat cement 2 Cement grout 3 Bentonite 4 Other  
 Grout Intervals: From (1) "0" ft. to 37 ft., From (3) 37 ft. to 40 ft., From ft. to ft.  
 What is the nearest source of possible contamination:  
 1 Septic tank 4 Lateral lines 7 Pit privy 10 Livestock pens 14 Abandoned water well  
 2 Sewer lines 5 Cess pool 8 Sewage lagoon 11 Fuel storage 15 Oil well/Gas well  
 3 Watertight sewer lines 6 Seepage pit 9 Feedyard 12 Fertilizer storage 16 Other (specify below)  
 13 Insecticide storage  
 Direction from well? UNKNOWN How many feet? UNKNOWN

FROM	TO	LITHOLOGIC LOG	FROM	TO	PLUGGING INTERVALS
0	7'	Black to brown topsoil.			
7	8.5	Clay			
8.5	10.5	Gray shale			
10.5	11.5	Limestone			
11.5	15	Shale and clay			
15	17	Limestone			
17	34	Limestone / Shale and Clay			
34	39	Limestone			
39	48.5	Gray shale			
48.5	59	Shale/clay silty gray shale			

**Note:** This form is filed late, the drilling contractor did not file this information at the completion of the work. This information is from the records at Argonne National Lab

7 CONTRACTOR'S OR LANDOWNER'S CERTIFICATION: This water well was (1) constructed, (2) reconstructed, or (3) plugged under my jurisdiction and was completed on (mo/day/year) 04/02/93 and this record is true to the best of my knowledge and belief. Kansas Water Well Contractor's Licence No. 680 This Water Well Record was completed on (mo/day/yr) 11/02/00 under the business name of Delta Environmental Services by (signature) David Suggs