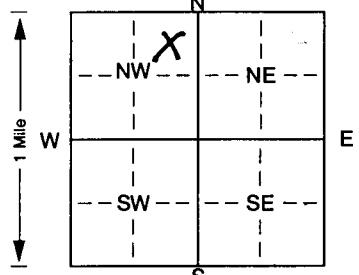


1] LOCATION OF WATER WELL: Fraction Section Number Township Number Range Number
 County: Dickinson NE ¼ NE ¼ NW ¼ 33 T 14 S R 3 EW
 Distance and direction from nearest town or city street address of well if located within city?
 From the intersection of May street & second street 80' north and 40' west. Navarre, KS

2] WATER WELL OWNER: USDA/CCC Farm Credit Service (MW-2)
 RR#, St. Address, Box # : 1400 Independence Ave, SW, Room 4723, Stop 0513 Board of Agriculture, Division of Water Resources
 City, State, ZIP Code : Washington, DC 20250-0513 Application Number:

3] LOCATE WELL'S LOCATION WITH AN "X" IN SECTION BOX: 4] DEPTH OF COMPLETED WELL: 57.8' ft. ELEVATION: 1,351'

 Depth(s) Groundwater Encountered 1. 46.8' ft. 2. ... ft. 3. ... ft.
 WELL'S STATIC WATER LEVEL ... 31.6' ft. below land surface measured on mo/day/yr ... 04./05/93.
 Pump test data: Well water was ... ft. after ... hours pumping ... gpm
 Est. Yield ... gpm: Well water was ... ft. after ... hours pumping ... gpm
 Bore Hole Diameter ... 8' in. to ... 60' ft., and ... in. to ... ft.
 WELL WATER TO BE USED AS: 5 Public water supply 8 Air conditioning 11 Injection well
 1 Domestic 3 Feedlot 6 Oil field water supply 9 Dewatering 12 Other (Specify below)
 2 Irrigation 4 Industrial 7 Domestic (lawn & garden) 10 Monitoring well
 Was a chemical/bacteriological sample submitted to Department? Yes. ... No. XXX; If yes, mo/day/yrs sample was submitted
 Water Well Disinfected? Yes No XX

5] TYPE OF BLANK CASING USED: 5 Wrought iron 8 Concrete tile CASING JOINTS: Glued. ... Clamped. ...
 1 Steel 3 RMP (SR) 6 Asbestos-Cement 9 Other (specify below) Welded. ...
 2 PVC 4 ABS 7 Fiberglass Threaded. ...
 Blank casing diameter ... 2' in. to ... 42.8' ft., Dia ... in. to ... ft., Dia ... in. to ... ft.
 Casing height above land surface ... 18' in., weight ... lbs./ft. Wall thickness or gauge No. Sch. 40.
 TYPE OF SCREEN OR PERFORATION MATERIAL: 7 PVC 10 Asbestos-cement
 1 Steel 3 Stainless steel 5 Fiberglass 8 RMP (SR) 11 Other (specify) ...
 2 Brass 4 Galvanized steel 6 Concrete tile 9 ABS 12 None used (open hole)
 SCREEN OR PERFORATION OPENINGS ARE: 5 Gauzed wrapped 8 Saw cut 11 None (open hole)
 1 Continuous slot 3 Mill slot 6 Wire wrapped 9 Drilled holes
 2 Louvered shutter 4 Key punched 7 Torch cut 10 Other (specify) ... ft.
 SCREEN-PERFORATED INTERVALS: From ... 42.8' ft. to ... 57.8' ft., From ... ft. to ... ft.
 GRAVEL PACK INTERVALS: From ... 38.5' ft. to ... 60.0' ft., From ... ft. to ... ft.
 From ... ft. to ... ft., From ... ft. to ... ft.

6] GROUT MATERIAL: 1 Neat cement 2 Cement grout 3 Bentonite 4 Other ...
 Grout Intervals: From (1) 0' ft. to ... 34.5' ft., From (3) 34.5' ft. to ... 38.5' ft., From ... ft. to ... ft.
 What is the nearest source of possible contamination:
 1 Septic tank 4 Lateral lines 7 Pit privy 10 Livestock pens 14 Abandoned water well
 2 Sewer lines 5 Cess pool 8 Sewage lagoon 11 Fuel storage 15 Oil well/Gas well
 3 Watertight sewer lines 6 Seepage pit 9 Feedyard 12 Fertilizer storage 16 Other (specify below)
 13 Insecticide storage
 Direction from well? Unknown How many feet? Unknown

FROM	TO	LITHOLOGIC LOG	FROM	TO	PLUGGING INTERVALS
0'	40'	No Sample			
40'	41'	Limestone			
41'	42'	Shale & Clay			
42'	45'	Claystone Gray/Brown			
45'	46'	Limestone			
46'	56'	Clay, Silt and some Shale			
56'	60'	Shale			

Note: This form is filed late, the original contractor did not file the forms at the time of completion. This form has been constructed from files and notes retained at Argonne National Laboratory 11/3/00

7] CONTRACTOR'S OR LANDOWNER'S CERTIFICATION: This water well was (1) constructed, (2) reconstructed, or (3) plugged under my jurisdiction and was completed on (mo/day/year) . 04/03/93. and this record is true to the best of my knowledge and belief. Kansas Water Well Contractor's Licence No. . 680. This Water Well Record was completed on (mo/day/yr) . 11/03/00. under the business name of Delta Environmental Services by (signature)