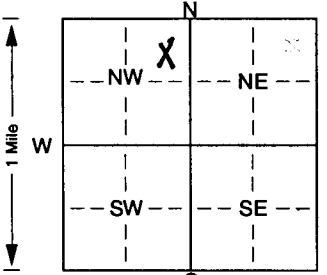


1 LOCATION OF WATER WELL: County: Dickinson	Fraction NE ¼ NE ¼ NW ¼	Section Number 33	Township Number T 14 S	Range Number R 3 (E)
--	----------------------------	----------------------	---------------------------	--------------------------------

Distance and direction from nearest town or city street address of well if located within city?
 20 feet Southeast of the intersection of May street & Second street.....Navarre, Knasas

2 WATER WELL OWNER: USDA/CCC Farm Credit Service (MW-4)
 RR#, St. Address, Box # : 1400 Independence Ave, SW, Room 4723, Stop 0513 Board of Agriculture, Division of Water Resources
 City, State, ZIP Code : Washington, DC 20250-0513 Application Number:

3 LOCATE WELL'S LOCATION WITH AN "X" IN SECTION BOX: 	4 DEPTH OF COMPLETED WELL... 60 ft. ELEVATION: 1,351' Depth(s) Groundwater Encountered 1. 45 ft. 2. 52.4 ft. 3. ft. WELL'S STATIC WATER LEVEL... 32.4 ft. below land surface measured on mo/day/yr 04/05/93 Pump test data: Well water was ft. after hours pumping gpm Est. Yield gpm: Well water was ft. after hours pumping gpm Bore Hole Diameter 8 in. to 60 ft., and in. to ft. WELL WATER TO BE USED AS: 5 Public water supply 8 Air conditioning 11 Injection well 1 Domestic 3 Feedlot 6 Oil field water supply 9 Dewatering 12 Other (Specify below) 2 Irrigation 4 Industrial 7 Domestic (lawn & garden) 10 Monitoring well Was a chemical/bacteriological sample submitted to Department? Yes. No. XX ; If yes, mo/day/yrs sample was submitted Water Well Disinfected? Yes No XX
--	--

5 TYPE OF BLANK CASING USED:
 1 Steel 3 RMP (SR) 5 Wrought iron 8 Concrete tile CASING JOINTS: Glued. Clamped.
2 PVC 4 ABS 6 Asbestos-Cement 9 Other (specify below) Welded.
 Blank casing diameter 2 in. to 45 ft., Dia in. to ft., Dia in. to ft.
 Casing height above land surface 18 in., weight lbs./ft. Wall thickness or gauge No. Sch. 40
 Threaded.

TYPE OF SCREEN OR PERFORATION MATERIAL:
 1 Steel 3 Stainless steel 5 Fiberglass **7 PVC** 10 Asbestos-cement
 2 Brass 4 Galvanized steel 6 Concrete tile 8 RMP (SR) 11 Other (specify)
 9 ABS 12 None used (open hole)

SCREEN OR PERFORATION OPENINGS ARE:
 1 Continuous slot 5 Gauzed wrapped 8 Saw cut 11 None (open hole)
 2 Louvered shutter **3 Mill slot** 6 Wire wrapped 9 Drilled holes
 4 Key punched 7 Torch cut 10 Other (specify) ft.

SCREEN-PERFORATED INTERVALS: From 45 ft. to 60 ft., From ft. to ft.
 From ft. to ft., From ft. to ft.
 GRAVEL PACK INTERVALS: From 41 ft. to 60 ft., From ft. to ft.
 From ft. to ft., From ft. to ft.

6 GROUT MATERIAL: 1 Neat cement 2 Cement grout 3 Bentonite 4 Other
 Grout Intervals: From (1) 0 ft. to 38 ft., From ft. to ft., From ft. to ft.
 What is the nearest source of possible contamination:
 1 Septic tank 4 Lateral lines 7 Pit privy 10 Livestock pens 14 Abandoned water well
 2 Sewer lines 5 Cess pool 8 Sewage lagoon 11 Fuel storage 15 Oil well/Gas well
 3 Watertight sewer lines 6 Seepage pit 9 Feedyard 12 Fertilizer storage 16 Other (specify below)
 13 Insecticide storage
 Direction from well? Unknown How many feet? Unknown

FROM	TO	LITHOLOGIC LOG	FROM	TO	PLUGGING INTERVALS
0	40'	No Data			
40'	44'	Clay & Silt, Gray to Green			
44'	45'	No Data			
45'	47'	Shale (Bleached)			
47'	49'	Clay & Silt (Dark Green)			
49'	51'	Shale (Bleached)			
51'	54.5'	Shale (Varicolored---Wet)			
54.5'	55'	Clay (Green vary moist)			
Note:xxx					
This form is filed late, the original contractor did not file the xxxxxxx forms at the completion of the well.					
This information is from the reports and records at Argonne National Lab.					

7 CONTRACTOR'S OR LANDOWNER'S CERTIFICATION: This water well was **(1)** constructed, (2) reconstructed, or (3) plugged under my jurisdiction and was completed on (mo/day/year) ... 04/03/93 ... and this record is true to the best of my knowledge and belief. Kansas Water Well Contractor's Licence No. ... 680 ... This Water Well Record was completed on (mo/day/yr) 11/06/00 under the business name of Delta Environmental Services by (signature) *[Signature]*