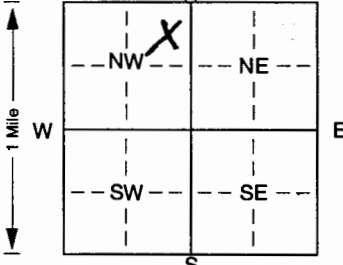


1] LOCATION OF WATER WELL: Dickinson
 County: Dickinson
 Fraction: NE 1/4 NE 1/4 NW 1/4
 Section Number: 33
 Township Number: T 14 S
 Range Number: R 3 E/W

Distance and direction from nearest town or city street address of well if located within city?
 Northeast corner of second street and May street, Navarre, Kansas

2] WATER WELL OWNER: USDA/CCC Farm Credit Service (T-1)
 RR#, St. Address, Box #: 1400 Independence Av, SW, Room 4723, Stop 0513 Board of Agriculture, Division of Water Resources
 City, State, ZIP Code: Washington, DC 20250-0513 Application Number:

3] LOCATE WELL'S LOCATION WITH AN "X" IN SECTION BOX:

 4] DEPTH OF COMPLETED WELL: 65 ft. ELEVATION: 1,350'
 Depth(s) Groundwater Encountered: 1. 39.5 ft. 2. ft. 3. ft.
 WELL'S STATIC WATER LEVEL: 31.7 ft. below land surface measured on mo/day/yr 04/04/93
 Pump test data: Well water was ft. after hours pumping gpm
 Est. Yield: 9 gpm Well water was ft. after hours pumping gpm
 Bore Hole Diameter: 1.2 in. to 6.5 ft., and in. to ft.
 WELL WATER TO BE USED AS:
 1 Domestic 3 Feedlot 6 Oil field water supply 8 Air conditioning 11 Injection well
 2 Irrigation 4 Industrial 7 Domestic (lawn & garden) 10 Monitoring well 12 Other (Specify below)
 Was a chemical/bacteriological sample submitted to Department? Yes. No. XX; If yes, mo/day/yr sample was submitted Water Well Disinfected? Yes No XX

5] TYPE OF BLANK CASING USED:
 1 Steel 3 RMP (SR) 5 Wrought iron 8 Concrete tile CASING JOINTS: Glued. Clamped.
 2 PVC 4 ABS 6 Asbestos-Cement 9 Other (specify below) Welded
 7 Fiberglass Threaded.
 Blank casing diameter: 6 in. to 6.0 ft., Dia. in. to ft., Dia. in. to ft.
 Casing height above land surface: 18 in., weight lbs./ft. Wall thickness or gauge No. Sch-40
 TYPE OF SCREEN OR PERFORATION MATERIAL:
 1 Steel 3 Stainless steel 5 Fiberglass 7 PVC 10 Asbestos-cement
 2 Brass 4 Galvanized steel 6 Concrete tile 8 RMP (SR) 11 Other (specify)
 9 ABS 12 None used (open hole)
 SCREEN OR PERFORATION OPENINGS ARE:
 1 Continuous slot 3 Mill slot 5 Gauzed wrapped 8 Saw cut 11 None (open hole)
 2 Louvered shutter 4 Key punched 6 Wire wrapped 9 Drilled holes
 7 Torch cut 10 Other (specify) ft.
 SCREEN-PERFORATED INTERVALS: From 40 ft. to 60 ft., From ft. to ft.
 From ft. to ft., From ft. to ft.
 GRAVEL PACK INTERVALS: From 37 ft. to 65 ft., From ft. to ft.
 From ft. to ft., From ft. to ft.

6] GROUT MATERIAL: 1 Neat cement 2 Cement grout 3 Bentonite 4 Other
 Grout Intervals: From (1) 0 ft. to 34 ft., From (3) 34 ft. to 37 ft., From ft. to ft.
 What is the nearest source of possible contamination:
 1 Septic tank 4 Lateral lines 7 Pit privy 10 Livestock pens 14 Abandoned water well
 2 Sewer lines 5 Cess pool 8 Sewage lagoon 11 Fuel storage 15 Oil well/Gas well
 3 Watertight sewer lines 6 Seepage pit 9 Feedyard 12 Fertilizer storage 16 Other (specify below)
 13 Insecticide storage
 Direction from well? Unknown How many feet? Unknown

FROM	TO	LITHOLOGIC LOG	FROM	TO	PLUGGING INTERVALS
0	6'	Clay & Silt			
6'	12.5'	Limestone			
12.5'	48.0'	Shale & Sand			
48.0'	55.0'	Limestone			
55.0'	60.0'	Gray Shale			
60.0'	65.0'	Clay & Silt			

Note: This form is filed late the Original contractor did not file the forms at the time of completion. This form has been constructed from the filed notes and records at Argonne National Laboratory, on November 3, 2000

7] CONTRACTOR'S OR LANDOWNER'S CERTIFICATION: This water well was (1) constructed, (2) reconstructed, or (3) plugged under my jurisdiction and was completed on (mo/day/year) 03/30/93 and this record is true to the best of my knowledge and belief. Kansas Water Well Contractor's Licence No. 680 This Water Well Record was completed on (mo/day/yr) 11/03/00 under the business name of Delta Environmental Services by (signature) [Signature]