


1 LOCATION OF WATER WELL: County: Dickinson Fraction: Ne 1/4 Ne 1/4 Se 1/4 Section Number: 2 Township Number: T 14 S Range Number: R 3 E  
 Distance and direction from nearest town or city street address of well if located within city?  
3 1/2 S 3 E Enterprise

2 WATER WELL OWNER: horen Peck  
 RR#, St. Address, Box #: RRI Board of Agriculture, Division of Water Resources  
 City, State, ZIP Code: Enterprise, KS. 67441 Application Number:

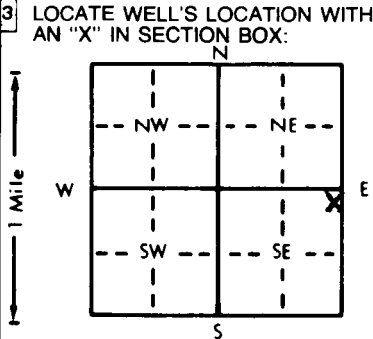

4 DEPTH OF COMPLETED WELL: 80 ft. ELEVATION: .....  
 Depth(s) Groundwater Encountered 1. 75 ft. 2. .... ft. 3. .... ft.  
 WELL'S STATIC WATER LEVEL 24 ft. below land surface measured on mo/day/yr 7-4-98  
 Pump test data: Well water was ..... ft. after ..... hours pumping ..... gpm  
 Est. Yield 25 gpm; Well water was ..... ft. after ..... hours pumping ..... gpm  
 Bore Hole Diameter: 8 1/2 in. to ..... ft., and ..... in. to ..... ft.  
 WELL WATER TO BE USED AS: 5 Public water supply 8 Air conditioning 11 Injection well  
 1 Domestic 3 Feedlot 6 Oil field water supply 9 Dewatering 12 Other (Specify below)  
 2 Irrigation 4 Industrial 7 Lawn and garden only 10 Monitoring well  
 Was a chemical/bacteriological sample submitted to Department? Yes ..... No X; If yes, mo/day/yr sample was submitted  
 Water Well Disinfected? Yes X No

5 TYPE OF BLANK CASING USED: 5 Wrought iron 8 Concrete tile CASING JOINTS: Glued X Clamped .....  
 1 Steel 3 RMP (SR) 6 Asbestos-Cement 9 Other (specify below) Welded .....  
 2 PVC 4 ABS 7 Fiberglass Threaded .....  
 Blank casing diameter 5 in. to 55 ft., Dia Class 160 in. to ..... ft., Dia ..... in. to ..... ft.  
 Casing height above land surface 12 in., weight Class 160 lbs./ft. Wall thickness or gauge No. 214  
 TYPE OF SCREEN OR PERFORATION MATERIAL: 7 PVC 10 Asbestos-cement  
 1 Steel 3 Stainless steel 5 Fiberglass 8 RMP (SR) 11 Other (specify) .....  
 2 Brass 4 Galvanized steel 6 Concrete tile 9 ABS 12 None used (open hole)  
 SCREEN OR PERFORATION OPENINGS ARE: 5 Gauzed wrapped 8 Saw cut 11 None (open hole)  
 1 Continuous slot 3 Mill slot 6 Wire wrapped 9 Drilled holes  
 2 Louvered shutter 4 Key punched 7 Torch cut 10 Other (specify) .....  
 SCREEN-PERFORATED INTERVALS: From 55 ft. to 80 ft., From ..... ft. to ..... ft.  
 From ..... ft. to ..... ft., From ..... ft. to ..... ft.  
 GRAVEL PACK INTERVALS: From 21 ft. to 80 ft., From ..... ft. to ..... ft.  
 From ..... ft. to ..... ft., From ..... ft. to ..... ft.

6 GROUT MATERIAL: 1 Neat cement 2 Cement grout 3 Bentonite 4 Other .....  
 Grout Intervals: From 0 ft. to 21 ft., From ..... ft. to ..... ft., From ..... ft. to ..... ft.  
 What is the nearest source of possible contamination: 10 Livestock pens 14 Abandoned water well  
 1 Septic tank 4 Lateral lines 7 Pit privy 11 Fuel storage 15 Oil well/Gas well  
 2 Sewer lines 5 Cess pool 8 Sewage lagoon 12 Fertilizer storage 16 Other (specify below)  
 3 Watertight sewer lines 6 Seepage pit 9 Feedyard 13 Insecticide storage  
 Direction from well? W How many feet? 100+

FROM	TO	LITHOLOGIC LOG	FROM	TO	PLUGGING INTERVALS
0	23	Loose lime & Shale			
23	32	Red Shale			
32	40	Gray "			
40	55	yellow Shale			
55	75	Lime			
75	76	Water			
76	80	Gray Rock			

7 CONTRACTOR'S OR LANDOWNER'S CERTIFICATION: This water well was (1) constructed, (2) reconstructed, or (3) plugged under my jurisdiction and was completed on (mo/day/year) 7-4-98 and this record is true to the best of my knowledge and belief. Kansas Water Well Contractor's License No. 180 This Water Well Record was completed on (mo/day/yr) 7-13-98 under the business name of Backhoe Drilling by (signature) Gaul H. Backhoe

OFFICE USE ONLY  
T  
R  
EW  
SEC.