


1 LOCATION OF WATER WELL: Fraction SE 1/4 SE 1/4 SE 1/4 Section Number 12 Township Number T 14 S Range Number R 4 E/W
 County: Dickinson

Distance and direction from nearest town or city street address of well if located within city?
1 1/4 miles East of Woodbine, Ks & 3 miles North

2 WATER WELL OWNER: Gerald Shippy
 RR#, St. Address, Box #: 1697 Wolf Rd Board of Agriculture, Division of Water Resources
 City, State, ZIP Code: Woodbine, Kansas 67492 Application Number:

3 LOCATE WELL'S LOCATION WITH AN "X" IN SECTION BOX:

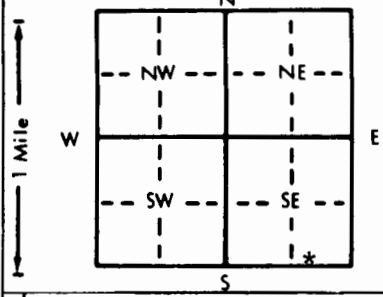

4 DEPTH OF COMPLETED WELL: 54 ft. ELEVATION:
 Depth(s) Groundwater Encountered 1. 24 ft. 2. 23 ft. 3. 10 / 20 / 95 ft.
 WELL'S STATIC WATER LEVEL 23 ft. below land surface measured on mo/day/yr 10 / 20 / 95

Pump test data: Well water was _____ ft. after _____ hours pumping _____ gpm
 Est. Yield 1.5+ gpm: Well water was _____ ft. after _____ hours pumping _____ gpm
 Bore Hole Diameter 9 in. to 5.4 ft., and _____ in. to _____ ft.

WELL WATER TO BE USED AS:
 1 Domestic 3 Feedlot 6 Oil field water supply 9 Dewatering 12 Other (Specify below)
 2 Irrigation 4 Industrial 7 Lawn and garden only 10 Monitoring well

Was a chemical/bacteriological sample submitted to Department? Yes _____ No *; If yes, mo/day/yr sample was submitted _____
 Water Well Disinfected? Yes * No

5 TYPE OF BLANK CASING USED:
 1 Steel 3 RMP (SR) 5 Wrought iron 8 Concrete tile CASING JOINTS: Glued * Clamped _____
 2 PVC 4 ABS 6 Asbestos-Cement 9 Other (specify below) Welded _____
 7 Fiberglass Threaded _____

Blank casing diameter 5 in. to 5.4 ft., Dia _____ in. to _____ ft., Dia _____ in. to _____ ft.
 Casing height above land surface 3 ft., weight 160 lbs./ft. Wall thickness or gauge No. 2.14

TYPE OF SCREEN OR PERFORATION MATERIAL:
 1 Steel 3 Stainless steel 5 Fiberglass 7 PVC 10 Asbestos-cement
 2 Brass 4 Galvanized steel 6 Concrete tile 9 ABS 11 Other (specify) _____
 12 None used (open hole)

SCREEN OR PERFORATION OPENINGS ARE:
 1 Continuous slot 3 Mill slot 5 Gauzed wrapped 8 Saw cut 11 None (open hole)
 2 Louvered shutter 4 Key punched 6 Wire wrapped 9 Drilled holes
 7 Torch cut 10 Other (specify) _____

SCREEN-PERFORATED INTERVALS: From 25 ft. to 54 ft., From _____ ft. to _____ ft.
 From _____ ft. to _____ ft., From _____ ft. to _____ ft.
 GRAVEL PACK INTERVALS: From 20-6" ft. to 54 ft., From _____ ft. to _____ ft.
 From _____ ft. to _____ ft., From _____ ft. to _____ ft.

6 GROUT MATERIAL: 1 Neat cement 2 Cement grout 3 Bentonite 4 Other _____
 Grout Intervals: From 6" ft. to 20-6" ft., From _____ ft. to _____ ft., From _____ ft. to _____ ft.

What is the nearest source of possible contamination:
 1 Septic tank 4 Lateral lines 7 Pit privy 10 Livestock pens 14 Abandoned water well
 2 Sewer lines 5 Cess pool 8 Sewage lagoon 11 Fuel storage 15 Oil well/Gas well
 3 Watertight sewer lines 6 Seepage pit 9 Feedyard 12 Fertilizer storage 16 Other (specify below)
 13 Insecticide storage

Direction from well? SOUTHEAST APPROX How many feet? 180

FROM	TO	LITHOLOGIC LOG	FROM	TO	PLUGGING INTERVALS
0	2	DARK TOP SOIL			
2	22	BROWN CLAY			
22	32	GRAVEL & HARD LIMESTONE & FLINT			
32	42	GRAY SHALE			
42	51	RED SHALE			
51	54	GRAY SHALE			

7 CONTRACTOR'S OR LANDOWNER'S CERTIFICATION: This water well was (1) constructed, (2) reconstructed, or (3) plugged under my jurisdiction and was completed on (mo/day/year) 10 / 20 / 95 and this record is true to the best of my knowledge and belief. Kansas Water Well Contractor's License No. 397. This Water Well Record was completed on (mo/day/yr) 10 / 23 / 95 under the business name of CENTRAL KANSAS DRILLING by (signature) Harold O. Martin