


1 LOCATION OF WATER WELL: Fraction Sw 1/4 Sw 1/4 NW 1/4 Section Number 3 Township Number T 14 S Range Number R 4-50 E
 County: Dickinson

Distance and direction from nearest town or city street address of well if located within city?
1/2 N 1 W Woodbine

2 WATER WELL OWNER: Carl Schmidt
 RR#, St. Address, Box #: RR 1
 City, State, ZIP Code: Chapman, KS. 67431
 Board of Agriculture, Division of Water Resources
 Application Number:

3 LOCATE WELL'S LOCATION WITH AN "X" IN SECTION BOX:

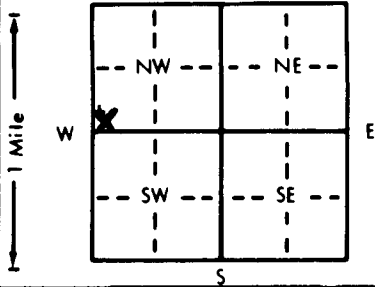

4 DEPTH OF COMPLETED WELL: 116 ft ELEVATION: _____
 Depth(s) Groundwater Encountered: 1. 79 ft. 2. _____ ft. 3. _____ ft.

WELL'S STATIC WATER LEVEL: 79 ft. below land surface measured on mo/day/yr 1-22-91
 Pump test data: Well water was _____ ft. after _____ hours pumping _____ gpm

Est. Yield 25 gpm Well water was _____ ft. after _____ hours pumping _____ gpm
 Bore Hole Diameter: 8 1/2 in. to _____ ft., and _____ in. to _____ ft.

WELL WATER TO BE USED AS:
 5 Public water supply 8 Air conditioning 11 Injection well
 1 Domestic 3 Feedlot 6 Oil field water supply 9 Dewatering 12 Other (Specify below)
 2 Irrigation 4 Industrial 7 Lawn and garden only 10 Monitoring well

Was a chemical/bacteriological sample submitted to Department? Yes _____ No X; If yes, mo/day/yr sample was submitted _____
 Water Well Disinfected? Yes X No _____

5 TYPE OF BLANK CASING USED:
 1 Steel 3 RMP (SR) 5 Wrought iron 8 Concrete tile CASING JOINTS: Glued X Clamped _____
 2 PVC 4 ABS 6 Asbestos-Cement 9 Other (specify below) Welded _____
 7 Fiberglass Threaded _____

Blank casing diameter: 5 in. to 80 ft., Dia. 5 in. to 111 ft., Dia. _____ in. to _____ ft.
 Casing height above land surface: 12 in., weight Class 160 lbs./ft. Wall thickness or gauge No. 214

TYPE OF SCREEN OR PERFORATION MATERIAL:
 1 Steel 3 Stainless steel 5 Fiberglass 7 PVC 10 Asbestos-cement
 2 Brass 4 Galvanized steel 6 Concrete tile 8 RMP (SR) 11 Other (specify) _____
 9 ABS 12 None used (open hole)

SCREEN OR PERFORATION OPENINGS ARE:
 1 Continuous slot 3 Mill slot 5 Gauzed wrapped 8 Saw cut 11 None (open hole)
 2 Louvered shutter 4 Key punched 6 Wire wrapped 9 Drilled holes
 7 Torch cut 10 Other (specify) _____

SCREEN-PERFORATED INTERVALS: From 80 ft. to 100 ft., From _____ ft. to _____ ft.
 From _____ ft. to _____ ft., From _____ ft. to _____ ft.

GRAVEL PACK INTERVALS: From 94 ft. to 111 ft., From _____ ft. to _____ ft.
 From _____ ft. to _____ ft., From _____ ft. to _____ ft.

6 GROUT MATERIAL: 4 Neat cement 24 Cement grout 3 Bentonite 4 Other _____
 Grout Intervals: From 4 ft. to 24 ft., From _____ ft. to _____ ft., From _____ ft. to _____ ft.

What is the nearest source of possible contamination:
 1 Septic tank 4 Lateral lines 7 Pit privy 10 Livestock pens 14 Abandoned water well
 2 Sewer lines 5 Cess pool 8 Sewage lagoon 11 Fuel storage 15 Oil well/Gas well
 3 Watertight sewer lines 6 Seepage pit 9 Feedyard 12 Fertilizer storage 16 Other (specify below)
 13 Insecticide storage

Direction from well? E
 How many feet? 50

FROM	TO	LITHOLOGIC LOG	FROM	TO	PLUGGING INTERVALS
0	9	Clay			
9	22	Lime			
22	35	Yellow Shale + mixed Clay			
35	72	Red Shale			
72	97	Lime			
97	98	Water			
98	111	Gray Rock			

7 CONTRACTOR'S OR LANDOWNER'S CERTIFICATION: This water well was (1) constructed, (2) reconstructed, or (3) plugged under my jurisdiction and was completed on (mo/day/year) 1-22-91 and this record is true to the best of my knowledge and belief. Kansas Water Well Contractor's License No. 1700 This Water Well Record was completed on (mo/day/yr) 1-22-91 under the business name of Backhus Drilling by (signature) Paul H. Backhus