

CORRECTION TO WATER WELL RECORD (WWC-5)

The following correction(s) was made to the attached WWC-5 log, in order to file the item or to rectify lacking or incorrect information.

Fraction (1/4 1/4 1/4) Section-Township-Range changed:

listed as NE NE NW, 6-14S-4-5E

changed to NE NE NW, 6-14S-4E

Other changes: Initial statements: _____

Changed to: _____

Comments: _____


verification method: Written & legal descriptions, position on plat map,
and Woodbine & Navarre 1:25,000 topo. maps. initials: DRd date: 5/4/2001

submitted by: Kansas Geological Survey, Data Resources Library, 1930 Constant Ave., Lawrence, KS 66047-3726
to: Kansas Dept of Health & Environment Bureau of Water Industrial Programs, Bldg 283, Forbes Field, KS 66620

1 LOCATION OF WATER WELL: Fraction Ne 1/4 Ne 1/4 NW 1/4 Section Number 6 Township Number T 17 S Range Number R 4-5 E
 County: Dickinson

Distance and direction from nearest town or city street address of well if located within city?
3 1/2 W 4 N Woodbine

2 WATER WELL OWNER: Gordon Taylor
 RR#, St. Address, Box #: BRI Box 48 Board of Agriculture, Division of Water Resources
 City, State, ZIP Code: Enterprise, Ke. 67441 Application Number:

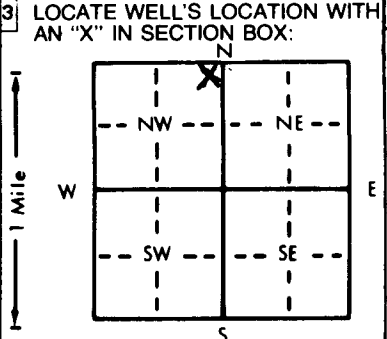

4 DEPTH OF COMPLETED WELL: 135 ft. ELEVATION: ft.
 Depth(s) Groundwater Encountered 1. 123 ft. 2. ft. 3. ft.
 WELL'S STATIC WATER LEVEL 98 ft. below land surface measured on mo/day/yr 10-26-92
 Pump test data: Well water was ft. after hours pumping gpm
 Est. Yield 30 gpm. Well water was ft. after hours pumping gpm
 Bore Hole Diameter: 2 1/2 in. to 135 ft., and in. to ft.
 WELL WATER TO BE USED AS:
 5 Public water supply 8 Air conditioning 11 Injection well
 1 Domestic 3 Feedlot 6 Oil field water supply 9 Dewatering 12 Other (Specify below)
 2 Irrigation 4 Industrial 7 Lawn and garden only 10 Monitoring well
 Was a chemical/bacteriological sample submitted to Department? Yes.....No X.....; If yes, mo/day/yr sample was submitted
 Water Well Disinfected? Yes X No

5 TYPE OF BLANK CASING USED:
 1 Steel 3 RMP (SR) 5 Wrought iron 8 Concrete tile CASING JOINTS: Glued X Clamped
 2 PVC 4 ABS 6 Asbestos-Cement 9 Other (specify below) Welded
 7 Fiberglass Threaded
 Blank casing diameter 5 in. to 115 ft., Dia. in. to ft., Dia. in. to ft.
 Casing height above land surface 12 in., weight Class 160 lbs./ft. Wall thickness or gauge No. 214
 TYPE OF SCREEN OR PERFORATION MATERIAL:
 1 Steel 3 Stainless steel 5 Fiberglass 7 PVC 10 Asbestos-cement
 2 Brass 4 Galvanized steel 6 Concrete tile 8 RMP (SR) 11 Other (specify)
 9 ABS 12 None used (open hole)
 SCREEN OR PERFORATION OPENINGS ARE:
 1 Continuous slot 3 Mill slot 5 Gauzed wrapped 8 Saw cut 11 None (open hole)
 2 Louvered shutter 4 Key punched 6 Wire wrapped 9 Drilled holes
 7 Torch cut 10 Other (specify)
 SCREEN-PERFORATED INTERVALS: From 115 ft. to 135 ft., From ft. to ft.
 From ft. to ft., From ft. to ft.
 GRAVEL PACK INTERVALS: From 23 ft. to 135 ft., From ft. to ft.
 From ft. to ft., From ft. to ft.

6 GROUT MATERIAL: 1 Neat cement 2 Cement grout 3 Bentonite 4 Other
 Grout Intervals: From 3 ft. to 23 ft., From ft. to ft., From ft. to ft.
 What is the nearest source of possible contamination:
 1 Septic tank 4 Lateral lines 7 Pit privy 10 Livestock pens 14 Abandoned water well
 2 Sewer lines 5 Cess pool 8 Sewage lagoon 11 Fuel storage 15 Oil well/Gas well
 3 Watertight sewer lines 6 Seepage pit 9 Feedyard 12 Fertilizer storage 16 Other (specify below)
 13 Insecticide storage
 Direction from well? in Pasture for Cattle How many feet? None within 1/4 mi

FROM	TO	LITHOLOGIC LOG	FROM	TO	PLUGGING INTERVALS
0	16	Clay			
16	29	lime			
29	45	Gray Shale			
45	57	Red "			
57	70	Blue "			
70	110	yellow shale & mixed lime			
110	118	Red Shale			
118	123	yellow " & lime			
123	124	Water			
124	133	Soft Lime			

7 CONTRACTOR'S OR LANDOWNER'S CERTIFICATION: This water well was (1) constructed, (2) reconstructed, or (3) plugged under my jurisdiction and was completed on (mo/day/year) 10-26-92 and this record is true to the best of my knowledge and belief. Kansas
 Water Well Contractor's License No. 180 This Water Well Record was completed on (mo/day/yr) 10-30-92
 under the business name of Backhus Drilling by (signature) Paul H. Backhus