


1 LOCATION OF WATER WELL: Fraction SW 1/4 NE 1/4 SW 1/4 Section Number 19 Township Number T 14 S Range Number R 4 E  
 County: Dickinson

Distance and direction from nearest town or city street address of well if located within city?  
2 1/2 N Woodbine East in Pasture

2 WATER WELL OWNER: Albers Farm Inc.  
 RR#, St. Address, Box #: RRI Box 11  
 City, State, ZIP Code: Chapman, KS. 67431  
 Board of Agriculture, Division of Water Resources  
 Application Number:

3 LOCATE WELL'S LOCATION WITH AN "X" IN SECTION BOX:

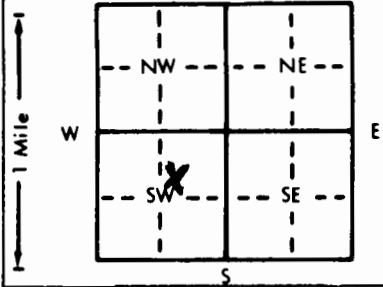

4 DEPTH OF COMPLETED WELL: 81 ft. ELEVATION: ..... ft.  
 Depth(s) Groundwater Encountered 1 72 ft. 2. .... ft. 3. .... ft.  
 WELL'S STATIC WATER LEVEL 53 ft. below land surface measured on mo/day/yr 4-15-91  
 Pump test data: Well water was ..... ft. after ..... hours pumping ..... gpm  
 Est. Yield 15 gpm: Well water was ..... ft. after ..... hours pumping ..... gpm  
 Bore Hole Diameter: 2 1/2 in. to 2 1 ft., and ..... in. to ..... ft.  
 WELL WATER TO BE USED AS:  
 1 Domestic 1 3 Feedlot 6 Oil field water supply 9 Dewatering 12 Other (Specify below)  
 2 Irrigation 4 Industrial 7 Lawn and garden only 10 Monitoring well  
 Was a chemical/bacteriological sample submitted to Department? Yes ..... No X; If yes, mo/day/yr sample was submitted  
 Water Well Disinfected? Yes X No

5 TYPE OF BLANK CASING USED:  
 1 Steel 3 RMP (SR) 5 Wrought iron 8 Concrete tile CASING JOINTS: Glued X Clamped .....  
 2 PVC 4 ABS 6 Asbestos-Cement 9 Other (specify below) Welded .....  
 7 Fiberglass Threaded .....

Blank casing diameter 5 in. to 6 1 ft., Dia. .... in. to ..... ft., Dia. .... in. to ..... ft.  
 Casing height above land surface 20 in., weight Class 160 lbs./ft. Wall thickness or gauge No. 2 14

TYPE OF SCREEN OR PERFORATION MATERIAL:  
 1 Steel 3 Stainless steel 5 Fiberglass 7 PVC 10 Asbestos-cement  
 2 Brass 4 Galvanized steel 6 Concrete tile 8 RMP (SR) 11 Other (specify) .....  
 9 ABS 12 None used (open hole)

SCREEN OR PERFORATION OPENINGS ARE:  
 1 Continuous slot 3 Mill slot 5 Gauzed wrapped 8 Saw cut 11 None (open hole)  
 2 Louvered shutter 4 Key punched 6 Wire wrapped 9 Drilled holes  
 7 Torch cut 10 Other (specify) .....

SCREEN-PERFORATED INTERVALS: From 6 1 ft. to 8 1 ft., From ..... ft. to ..... ft.  
 From ..... ft. to ..... ft., From ..... ft. to ..... ft.  
 GRAVEL PACK INTERVALS: From 2 1 ft. to 8 1 ft., From ..... ft. to ..... ft.  
 From ..... ft. to ..... ft., From ..... ft. to ..... ft.

6 GROUT MATERIAL: 1 Neat cement 2 Cement grout 3 Bentonite 4 Other .....  
 Grout Intervals: From 0 ft. to 2 1 ft., From ..... ft. to ..... ft., From ..... ft. to ..... ft.

What is the nearest source of possible contamination:  
 1 Septic tank 4 Lateral lines 7 Pit privy 10 Livestock pens 14 Abandoned water well  
 2 Sewer lines 5 Cess pool 8 Sewage lagoon 11 Fuel storage 15 Oil well/Gas well  
 3 Watertight sewer lines 6 Seepage pit 9 Feedyard 12 Fertilizer storage 16 Other (specify below)  
 13 Insecticide storage

Direction from well? None within 1/2 mi How many feet?

FROM	TO	LITHOLOGIC LOG	FROM	TO	PLUGGING INTERVALS
0	38	Red Clay			
38	57	limestone			
57	72	Gray Shale + mixed White Rock			
72	73	Water			
73	81	Gray Rock			

7 CONTRACTOR'S OR LANDOWNER'S CERTIFICATION: This water well was (1) constructed (2) reconstructed, or (3) plugged under my jurisdiction and was completed on (mo/day/year) 4-15-91 and this record is true to the best of my knowledge and belief. Kansas Water Well Contractor's License No. 180 This Water Well Record was completed on (mo/day/yr) 4-15-91 under the business name of Backhus Drilling by (signature) Paul H. Backhus