**WATER WELL RECORD Form WWC-5**

☐ Original Record ☐ Correction ☐ Change in Well Use

Division of Water Resources App. No. ____ Well ID ____

**1 LOCATION OF WATER WELL:** County: Dickinson | Fraction: ¼ Se ¼ Se ¼ No. | Section Number: 16 | Township Number: T 14S | Range Number: R 4 ☑ E ☐ W

**2 WELL OWNER:** Last Name: Shippy First: William
Business:
Address: 1523 Union Rd
Address:
City: Woodbine State: KS ZIP: 67492

Street or Rural Address where well is located (if unknown, distance and direction from nearest town or intersection): If at owner's address, check here: ☐

**3 LOCATE WELL WITH "X" IN SECTION BOX:**

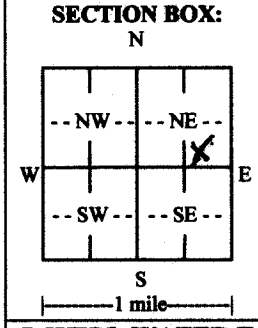


**4 DEPTH OF COMPLETED WELL:** 75 ft.
Depth(s) Groundwater Encountered: 1) 60 ft. 2) ..... ft. 3) ..... ft., or 4) ☐ Dry Well
WELL'S STATIC WATER LEVEL: 55 ft.
☐ below land surface, measured on (mo-day-yr) .....
☑ above land surface, measured on (mo-day-yr) 3-26-15
Pump test data: Well water was ..... ft. after ..... hours pumping ..... gpm
Well water was ..... ft. after ..... hours pumping ..... gpm
Estimated Yield: 20 gpm
Bore Hole Diameter: 12 in. to 20 ft. and 7⅞ in. to 75 ft.

**5 Latitude:** ..... (decimal degrees)
**Longitude:** ..... (decimal degrees)
Datum: ☐ WGS 84 ☐ NAD 83 ☐ NAD 27
Source for Latitude/Longitude:
☐ GPS (unit make/model: .....) (WAAS enabled? ☐ Yes ☐ No)
☐ Land Survey ☐ Topographic Map
☐ Online Mapper: .....

**6 Elevation:** ..... ft. ☐ Ground Level ☐ TOC
Source: ☐ Land Survey ☐ GPS ☐ Topographic Map ☐ Other .....

**7 WELL WATER TO BE USED AS:**
1. Domestic: ☐ Household ☐ Lawn & Garden ☑ Livestock
2. ☐ Irrigation
3. ☐ Feedlot
4. ☐ Industrial
5. ☐ Public Water Supply: well ID .....
6. ☐ Dewatering: how many wells? .....
7. ☐ Aquifer Recharge: well ID .....
8. ☐ Monitoring: well ID .....
9. Environmental Remediation: well ID ..... ☐ Air Sparge ☐ Soil Vapor Extraction ☐ Recovery ☐ Injection
10. ☐ Oil Field Water Supply: lease .....
11. Test Hole: well ID ..... ☐ Cased ☐ Uncased ☐ Geotechnical
12. Geothermal: how many bores? ..... a) Closed Loop ☐ Horizontal ☐ Vertical b) Open Loop ☐ Surface Discharge ☐ Inj. of Water
13. ☐ Other (specify): .....

**Was a chemical/bacteriological sample submitted to KDHE?** ☐ Yes ☑ No If yes, date sample was submitted: .....
Water well disinfected? ☑ Yes ☐ No

**8 TYPE OF CASING USED:** ☐ Steel ☑ PVC ☐ Other ..... CASING JOINTS: ☑ Glued ☐ Clamped ☐ Welded ☐ Threaded
Casing diameter 5 in. to 75 ft., Diameter ..... in. to ..... ft., Diameter ..... in. to ..... ft.
Casing height above land surface 12 in. Weight SDR26 lbs./ft. Wall thickness or gauge No. 214
TYPE OF SCREEN OR PERFORATION MATERIAL:
☐ Steel ☐ Stainless Steel ☐ Fiberglass ☑ PVC ☐ Other (Specify) .....
☐ Brass ☐ Galvanized Steel ☐ Concrete tile ☐ None used (open hole)
SCREEN OR PERFORATION OPENINGS ARE:
☐ Continuous Slot ☐ Mill Slot ☐ Gauze Wrapped ☐ Torch Cut ☐ Drilled Holes ☐ Other (Specify) .....
☐ Louvered Shutter ☐ Key Punched ☐ Wire Wrapped ☑ Saw Cut ☐ None (Open Hole)
SCREEN-PERFORATED INTERVALS: From 50 ft. to 75 ft., From ..... ft. to ..... ft., From ..... ft. to ..... ft.
GRAVEL PACK INTERVALS: From 20 ft. to 75 ft., From ..... ft. to ..... ft., From ..... ft. to ..... ft.

**9 GROUT MATERIAL:** ☐ Neat cement ☐ Cement grout ☑ Bentonite ☐ Other .....
Grout Intervals: From 0 ft. to 20 ft., From ..... ft. to ..... ft., From ..... ft. to ..... ft.
**Nearest source of possible contamination:**
☐ Septic Tank ☐ Lateral Lines ☐ Pit Privy ☑ Livestock Pens ☐ Insecticide Storage
☐ Sewer Lines ☐ Cess Pool ☐ Sewage Lagoon ☐ Fuel Storage ☐ Abandoned Water Well
☐ Watertight Sewer Lines ☐ Seepage Pit ☐ Feedyard ☐ Fertilizer Storage ☐ Oil Well/Gas Well
☐ Other (Specify) .....
Direction from well? E Distance from well? 150 ft.

| 10 FROM | TO | LITHOLOGIC LOG | FROM | TO | LITHO. LOG (cont.) or PLUGGING INTERVALS |
|---|---|---|---|---|---|
| 0 | 10 | Top Soil + Yellow Clay | | | |
| 10 | 28 | Limstone | | | |
| 28 | 45 | Red Shale | | | |
| 45 | 67 | Brown " | | | |
| 67 | 68 | Water | | | |
| 68 | 75 | Blue Shale | | | |
| | | | Notes: | | |

**11 CONTRACTOR'S OR LANDOWNER'S CERTIFICATION:** This water well was ☑ constructed, ☐ reconstructed, or ☐ plugged under my jurisdiction and was completed on (mo-day-year) 3-26-15 and this record is true to the best of my knowledge and belief. Kansas Water Well Contractor's License No. 180 This Water Well Record was completed on (mo-day-year) 3-27-15 under the business name of Backus Drilling

INSTRUCTIONS: Send one copy to WATER WELL OWNER and retain one copy for your records. Submit fee of $5.00 for each constructed well along with one (white) copy to Kansas Department of Health and Environment, Bureau of Water, Geology Section, 1000 SW Jackson St., Suite 420, Topeka, Kansas 66612-1367. Telephone (785) 296-3565.

Visit us at http://www.kdheks.gov/waterwell/index.html KSA 82a-1212 Revised 9/10/2012