USE TYPEWRITER OR BALL POINT PEN-PRESS FIRMLY, PRINT CLEARLY.

T R EW sec 1/4 1/4 1/4 No.

WATER WELL RECORD
KSA 82a-1201-1215

Kansas State Dept. Of Health
(Water Well Contractors)
Forbes-Bldg. 740
Topeka, Kansas 66620

1 Location of well:	County	Township name	Fraction	Section number	Town number	Range number
	Dickinson	Liberty	NE¼ NE¼ NE¼	5	14S	5-E

Distance and direction from nearest town or city: ~~7 miles north of Woodbine~~
Street address of well location if in city:

3 Owner of well: Rock Springs Camp
Address: Woodbine, KS

Locate with "X" in section below:

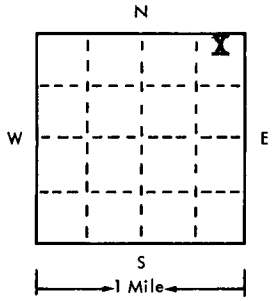

Sketch map: One mile E of Woodbine
5 " N " "
2 " E " "
Corner Intersection of Dickinson, Morris and Geary Counties.

4 Well depth: 50 ft. Date of completion 1-21-75
Well diameter 9 in.

5 ☐ Cable tool ☒ Rotary ☐ Driven ☐ Dug
☐ Hollow rod ☐ Jetted ☐ Bored ☐ Reverse rotary

6 Use: ☒ Domestic ☐ Public supply ☐ Industry
☐ Irrigation ☐ Air conditioning ☐ Commercial
☐ Test well ☐

7 Casing: Material Plastic Height: (above) below
Threaded ☐ Welded ☐ Surface 12 in.
Diam. Weight 160 lbs./ft.
5 in. to 50 ft. depth Drive shoe? ☐ Yes ☐ No
in. to ft. depth

8 Screen: Plastic slot
Manufacturer Certain-Teed
Type PVC Dia. 5"
(Slot) gauze 116 Length 10'
Set between 40 ft. and 50 ft.
Fittings:
Gravel pack ☒ Yes ☐ No Size range of material 1/2-1/4

9 Static water level:
35 ft. below land surface Date 1-22-75

10 Pumping level below land surfaces: Not Installed
ft. after hrs. pumping g.p.m.
ft. after hrs. pumping g.p.m.
Estimated maximum yield g.p.m.

11 Water sample submitted:
☐ Yes ☒ No Date

12 Well head completion:
☐ Pitless adapter ☐ Inches above grade

13 Well grouted? ☒ Yes ☐ No
☒ Neat cement ☐ Bentonite ☐
Depth: From 1 ft. to 10 ft.

14 Nearest source of possible contamination: pasture
ft. 50 Direction east Type Lot
Well disinfected upon completion? ☒ Yes ☐ No

15 Pump: ☒ Not installed
Manufacturer's name
Model number HP Volts
Length of drop pipe ft. capacity g.m.p.
Type:
☐ Submersible ☐ Turbine
☐ Jet ☐ Reciprocating
☐ Certrifugal ☐ Other

2 Type and color of material	From	To
0-2 Top Soil	0	2
2-45 Lime Stone	2	45
Water & Lime Stone	45	50
(use a second sheet if needed)		

16 Remarks: elevation

Topography:
☒ Hill
☐ Slope
☐ Upland
☐ Valley

17 Water well contractor's certification:
This well was drilled under my jurisdiction and this report is true to the best of my knowledge and belief.
Backhus Drilling Inc
Business name License No.
Address Tampa, Ks 67483
Signed Paul Backhus Date 1-22-75
Authorized representative

Forward the white, blue and pink copies to the Kansas State Dept. Of Health.

Form WWC-5

677-H