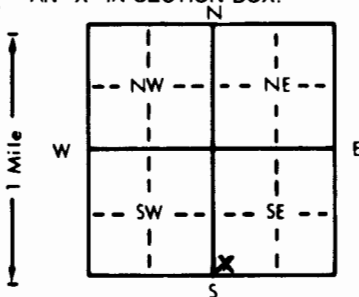


1 LOCATION OF WATER WELL: County: Morris Fraction: SW 1/4 SW 1/4 SE 1/4 Section Number: 6 Township Number: T 14 S Range Number: R 5 E

Distance and direction from nearest town or city street address of well if located within city?  
7 N 1/2 E Herington

2 WATER WELL OWNER: Rodger Deikman  
 RR#, St. Address, Box #: Woodbine, KS. 67492  
 City, State, ZIP Code: Woodbine, KS. 67492  
 Board of Agriculture, Division of Water Resources  
 Application Number:

3 LOCATE WELL'S LOCATION WITH AN "X" IN SECTION BOX:  
  
 4 DEPTH OF COMPLETED WELL: 105 ft. ELEVATION:  
 Depth(s) Groundwater Encountered 1. 79 ft. 2. ft. 3. ft.  
 WELL'S STATIC WATER LEVEL: 78 ft. below land surface measured on 6-12-00  
 Pump test data: Well water was ft. after hours pumping gpm  
 Est. Yield 20 gpm: Well water was ft. after hours pumping gpm  
 Bore Hole Diameter: 1 1/2 in. to 105 ft., and in. to ft.  
 WELL WATER TO BE USED AS:  
 1 Domestic 3 Feedlot 6 Oil field water supply 9 Dewatering 12 Other (Specify below)  
 2 Irrigation 4 Industrial 7 Lawn and garden only 10 Monitoring well  
 Was a chemical/bacteriological sample submitted to Department? Yes No X; If yes, mo/day/yr sample was submitted  
 Water Well Disinfected? Yes X No

5 TYPE OF BLANK CASING USED:  
 1 Steel 3 RMP (SR) 6 Asbestos-Cement 9 Other (specify below)  
 2 PVC 4 ABS 7 Fiberglass  
 Blank casing diameter: 5 in. to 75 ft. Dia. in. to ft. Dia. in. to ft.  
 Casing height above land surface: 12 in., weight Class 160 lbs./ft. Wall thickness or gauge No. 214  
 TYPE OF SCREEN OR PERFORATION MATERIAL:  
 1 Steel 3 Stainless steel 5 Fiberglass 8 RMP (SR) 11 Other (specify)  
 2 Brass 4 Galvanized steel 6 Concrete tile 9 ABS 12 None used (open hole)  
 SCREEN OR PERFORATION OPENINGS ARE:  
 1 Continuous slot 3 Mill slot 6 Wire wrapped 9 Drilled holes  
 2 Louvered shutter 4 Key punched 7 Torch cut 10 Other (specify)  
 SCREEN-PERFORATED INTERVALS: From 75 ft. to 105 ft., From ft. to ft.  
 GRAVEL PACK INTERVALS: From 20 ft. to 105 ft., From ft. to ft.

6 GROUT MATERIAL: 1 Neat cement 2 Cement grout 3 Bentonite 4 Other  
 Grout Intervals: From 0 ft. to 20 ft., From ft. to ft., From ft. to ft.  
 What is the nearest source of possible contamination:  
 1 Septic tank 4 Lateral lines 7 Pit privy 10 Livestock pens 14 Abandoned water well  
 2 Sewer lines 5 Cess pool 8 Sewage lagoon 11 Fuel storage 15 Oil well/Gas well  
 3 Watertight sewer lines 6 Seepage pit 9 Feedyard 12 Fertilizer storage 16 Other (specify below)  
 Direction from well? NE How many feet? 200+

FROM	TO	LITHOLOGIC LOG	FROM	TO	PLUGGING INTERVALS
2	2	Clay			
2	12	Lime			
12	55	Yellow Clay mixed Shale			
55	78	Red Shale			
78	79	Water			
79	90	Lime			
90	102	Gray Clay			
102	105	Blue Shale			

7 CONTRACTOR'S OR LANDOWNER'S CERTIFICATION: This water well was (1) constructed, (2) reconstructed, or (3) plugged under my jurisdiction and was completed on (mo/day/year) 6-12-00 and this record is true to the best of my knowledge and belief. Kansas Water Well Contractor's License No. 180 This Water Well Record was completed on (mo/day/yr) 6-27-00 under the business name of Backhoe Drilling by (signature) Paul A. Backhoe

OFFICE USE ONLY

T

R

EW

SEC.

1/4

1/4

1/4