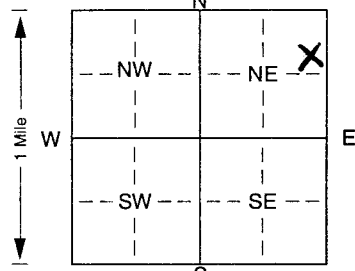


1 LOCATION OF WATER WELL:	Fraction	Section Number	Township Number	Range Number
County: <u>Morris</u>	<u>Se 1/4 N1/2 E1/4</u>	<u>25</u>	T <u>14</u> S	R <u>5</u> <u>EW</u>

Distance and direction from nearest town or city street address of well if located within city?

7 E 2 N Woodbine

2 WATER WELL OWNER:	Board of Agriculture, Division of Water Resources
RR#, St. Address, Box # : <u>3553 Upland Rd</u>	Application Number:
City, State, ZIP Code : <u>Lost Springs, K.S. 66859</u>	

3 LOCATE WELL'S LOCATION WITH	4 DEPTH OF COMPLETED WELL	ELEVATION:
AN "X" IN SECTION BOX:	Depth(s) Groundwater Encountered	ft. 2. ft. 3. ft.
	WELL'S STATIC WATER LEVEL <u>29</u> ft. below land surface measured on mo/day/yr <u>6-7-02</u>	
	Pump test data: Well water was ft. after hours pumping gpm	
	Est. Yield <u>2.5</u> gpm: Well water was ft. after hours pumping gpm	
	Bore Hole Diameter <u>8 1/2</u> in. to <u>7 1/2</u> ft., and in. to ft.	
	WELL WATER TO BE USED AS:	
	1 Domestic 3 Feedlot 6 Oil field water supply 9 Dewatering 12 Other (Specify below)	
	2 Irrigation 4 Industrial 7 Domestic (lawn & garden) 10 Monitoring well	
	* Was a chemical/bacteriological sample submitted to Department? Yes. No. ; If yes, mo/day/yr sample was submitted	
	Water Well Disinfected? Yes No	

5 TYPE OF BLANK CASING USED:	5 Wrought iron	8 Concrete tile	CASING JOINTS: Glued. Clamped.
1 Steel	3 RMP (SR)	6 Asbestos-Cement	9 Other (specify below)
2 PVC	4 ABS	7 Fiberglass	10 Asbestos-cement
Blank casing diameter <u>5</u> in. to <u>5 1/2</u> ft., Dia.			11 Other (specify)
Casing height above land surface <u>12</u> in., weight <u>Class 160</u> lbs./ft. Wall thickness or gauge No. <u>214</u>			12 None used (open hole)
TYPE OF SCREEN OR PERFORATION MATERIAL:	7 PVC	10 Asbestos-cement	
1 Steel	8 RMP (SR)	11 Other (specify)	
2 Brass	9 ABS	12 None used (open hole)	
3 Stainless steel			
4 Galvanized steel			
5 Fiberglass			
6 Concrete tile			
SCREEN OR PERFORATION OPENINGS ARE:	5 Gauzed wrapped	8 Saw cut	11 None (open hole)
1 Continuous slot	6 Wire wrapped	9 Drilled holes	
2 Louvered shutter	7 Torch cut	10 Other (specify)	
3 Mill slot			
4 Key punched			
SCREEN-PERFORATED INTERVALS: From <u>5 1/2</u> ft. to <u>7 1/2</u> ft., From ft. to ft.			
From ft. to ft., From ft. to ft.			
GRAVEL PACK INTERVALS: From <u>2 1/2</u> ft. to <u>7 1/2</u> ft., From ft. to ft.			
From ft. to ft., From ft. to ft.			

6 GROUT MATERIAL:	1 Neat cement	2 Cement grout	3 Bentonite	4 Other
Grout Intervals: From <u>5</u> ft. to <u>2 1/2</u> ft., From ft. to ft., From ft. to ft.				
What is the nearest source of possible contamination:	10 Livestock pens	14 Abandoned water well		
1 Septic tank	11 Fuel storage	15 Oil well/Gas well		
2 Sewer lines	12 Fertilizer storage	16 Other (specify below)		
3 Watertight sewer lines	13 Insecticide storage			
4 Lateral lines				
5 Cess pool				
6 Seepage pit				
7 Pit privy				
8 Sewage lagoon				
9 Feedyard				
Direction from well? <u>In pasture for cattle</u>	How many feet? <u>None within 1/4 mile</u>			

FROM	TO	LITHOLOGIC LOG	FROM	TO	PLUGGING INTERVALS
<u>0</u>	<u>6</u>	<u>Clay</u>			
<u>6</u>	<u>25</u>	<u>Lime</u>			
<u>25</u>	<u>32</u>	<u>Red Shale</u>			
<u>32</u>	<u>67</u>	<u>Gray Hard Shale</u>			
<u>67</u>	<u>70</u>	<u>Yellow Flint Rock Water</u>			
<u>70</u>	<u>75</u>	<u>Hard Gray Shale</u>			

7 CONTRACTOR'S OR LANDOWNER'S CERTIFICATION: This water well was (1) <u>constructed</u> , (2) reconstructed, or (3) plugged under my jurisdiction and was completed on (mo/day/year) <u>6-7-02</u> and this record is true to the best of my knowledge and belief. Kansas Water Well Contractor's Licence No. This Water Well Record was completed on (mo/day/yr) <u>6-8-02</u> under the business name of <u>Backhus Drilling</u> by (signature) <u>Paul H. Backhus</u>
--