


1 LOCATION OF WATER WELL: Fraction Sw 1/4 SW 1/4 NW 1/4 Section Number 1 Township Number T 14 S Range Number R 5 E
 County: Morris Distance and direction from nearest town or city street address of well if located within city? 2 1/2 W to Skiddy

2 WATER WELL OWNER: F.A. Schelhorn Board of Agriculture, Division of Water Resources
 RR#, St. Address, Box #: BRI Box 63 Application Number:
 City, State, ZIP Code: Junction City, KS. 66441

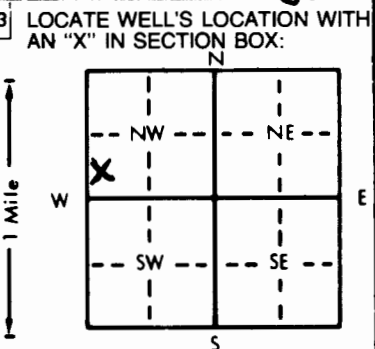

4 DEPTH OF COMPLETED WELL: 148 ft. ELEVATION:
 Depth(s) Groundwater Encountered 1. 120 ft. 2. ft. 3. ft.
 WELL'S STATIC WATER LEVEL 100 ft. below land surface measured on mo/day/yr 11-29-89
 Pump test data: Well water was ft. after hours pumping gpm
 Est. Yield 5 gpm Well water was ft. after hours pumping gpm
 Bore Hole Diameter: 8 1/2 in. to 40 ft., and 7 1/2 in. to 148 ft.
 WELL WATER TO BE USED AS:
 1 Domestic 3 Feedlot 6 Oil field water supply 9 Dewatering 12 Other (Specify below)
 2 Irrigation 4 Industrial 7 Lawn and garden only 10 Monitoring well
 Was a chemical/bacteriological sample submitted to Department? Yes.....No X.....; If yes, mo/day/yr sample was submitted
 Water Well Disinfected? Yes X No

5 TYPE OF BLANK CASING USED:
 1 Steel 3 RMP (SR) 5 Wrought iron 8 Concrete tile CASING JOINTS: Glued X Clamped
 2 PVC 4 ABS 6 Asbestos-Cement 9 Other (specify below) Welded
 7 Fiberglass Threaded
 Blank casing diameter 5 in. to 105 ft. Dia. in. to ft. Dia. in. to ft.
 Casing height above land surface 15 in., weight CLASS 160 lbs./ft. Wall thickness or gauge No. 214
 TYPE OF SCREEN OR PERFORATION MATERIAL:
 1 Steel 3 Stainless steel 5 Fiberglass 7 PVC 10 Asbestos-cement
 2 Brass 4 Galvanized steel 6 Concrete tile 8 RMP (SR) 11 Other (specify)
 9 ABS 12 None used (open hole)
 SCREEN OR PERFORATION OPENINGS ARE:
 1 Continuous slot 3 Mill slot 5 Gauzed wrapped 8 Saw cut 11 None (open hole)
 2 Louvered shutter 4 Key punched 6 Wire wrapped 9 Drilled holes
 7 Torch cut 10 Other (specify)
 SCREEN-PERFORATED INTERVALS: From 105 ft. to 148 ft. From ft. to ft.
 GRAVEL PACK INTERVALS: From ft. to ft. From ft. to ft.

6 GROUT MATERIAL: 1 Neat cement 2 Cement grout 3 Bentonite 4 Other Hole Plug
 Grout Intervals: From 0 ft. to 28 ft., From ft. to ft., From ft. to ft.
 What is the nearest source of possible contamination:
 1 Septic tank 4 Lateral lines 7 Pit privy 10 Livestock pens 14 Abandoned water well
 2 Sewer lines 5 Cess pool 8 Sewage lagoon 11 Fuel storage 15 Oil well/Gas well
 3 Watertight sewer lines 6 Seepage pit 9 Feedyard 12 Fertilizer storage 16 Other (specify below)
 13 Insecticide storage
 Direction from well? S How many feet? 100+

FROM	TO	LITHOLOGIC LOG	FROM	TO	PLUGGING INTERVALS
0	22	Clay			
22	26	Hard Rock			
26	65	Clay + mixed Shale			
65	95	Lime + mixed "			
95	120	Gray Rock			
120	121	Water			
121	148	Gray Rock			

7 CONTRACTOR'S OR LANDOWNER'S CERTIFICATION: This water well was (1) constructed, (2) reconstructed, or (3) plugged under my jurisdiction and was completed on (mo/day/year) 11-29-89 and this record is true to the best of my knowledge and belief. Kansas Water Well Contractor's License No. 170 This Water Well Record was completed on (mo/day/yr) 11-30-89 under the business name of Backus Drilling by (signature) Paul Backus

OFFICE USE ONLY T R E W SEC.