


1 LOCATION OF WATER WELL: Fraction Ne 1/4 Ne 1/4 Se 1/4 Section Number 1 Township Number T 14 S Range Number R 50 E
 County: Morris
 Distance and direction from nearest town, or city street address of well if located within city?
1 1/2 W 1/2 S Skiddy

2 WATER WELL OWNER: Mark Janke
 RR#, St. Address, Box #: RR1
 City, State, ZIP Code: Junction, City, KS 66441
 Board of Agriculture, Division of Water Resources
 Application Number:

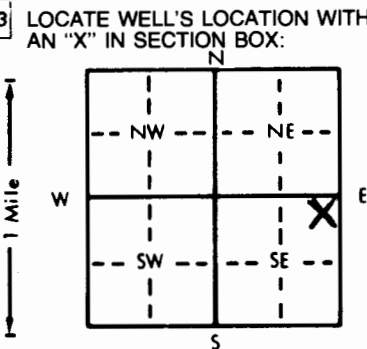

4 DEPTH OF COMPLETED WELL: _____ ft. ELEVATION: _____ ft.
 Depth(s) Groundwater Encountered 1 122 ft. 2. _____ ft. 3. _____ ft.
 WELL'S STATIC WATER LEVEL 62 ft. below land surface measured on mo/day/yr 11-20-89
 Pump test data: Well water was _____ ft. after _____ hours pumping _____ gpm
 Est. Yield 8 gpm: Well water was _____ ft. after _____ hours pumping _____ gpm
 Bore Hole Diameter: 8 1/2 in. to 50 ft., and 7 1/2 in. to 140 ft.
 WELL WATER TO BE USED AS:
 1 Domestic 3 Feedlot 6 Oil field water supply 9 Dewatering 12 Other (Specify below)
 2 Irrigation 4 Industrial 7 Lawn and garden only 10 Monitoring well
 Was a chemical/bacteriological sample submitted to Department? Yes _____ No X; If yes, mo/day/yr sample was submitted _____
 Water Well Disinfected? Yes X No _____

5 TYPE OF BLANK CASING USED:
 1 Steel 3 RMP (SR) 5 Wrought iron 8 Concrete tile CASING JOINTS: Glued X Clamped _____
 2 PVC 4 ABS 6 Asbestos-Cement 9 Other (specify below) Welded _____
 7 Fiberglass Threaded _____
 Blank casing diameter 5 in. to 115 ft. Dia _____ in. to _____ ft. Dia _____ in. to _____ ft.
 Casing height above land surface 12 in., weight CLASS 160 lbs./ft. Wall thickness or gauge No. 214
 TYPE OF SCREEN OR PERFORATION MATERIAL:
 1 Steel 3 Stainless steel 5 Fiberglass 7 PVC 10 Asbestos-cement
 2 Brass 4 Galvanized steel 6 Concrete tile 8 RMP (SR) 11 Other (specify) _____
 9 ABS 12 None used (open hole)
 SCREEN OR PERFORATION OPENINGS ARE:
 1 Continuous slot 3 Mill slot 5 Gauzed wrapped 8 Saw cut 11 None (open hole)
 2 Louvered shutter 4 Key punched 6 Wire wrapped 9 Drilled holes
 7 Torch cut 10 Other (specify) _____
 SCREEN-PERFORATED INTERVALS: From 115 ft. to 140 ft., From _____ ft. to _____ ft.
 From _____ ft. to _____ ft., From _____ ft. to _____ ft.
 GRAVEL PACK INTERVALS: From _____ ft. to _____ ft., From _____ ft. to _____ ft.
 From _____ ft. to _____ ft., From _____ ft. to _____ ft.

6 GROUT MATERIAL: 1 Neat cement 2 Cement grout 3 Bentonite 4 Other Hole Plug
 Grout intervals: From 0 ft. to 30 ft., From _____ ft. to _____ ft., From _____ ft. to _____ ft.
 What is the nearest source of possible contamination:
 1 Septic tank 4 Lateral lines 7 Pit privy 10 Livestock pens 14 Abandoned water well
 2 Sewer lines 5 Cess pool 8 Sewage lagoon 11 Fuel storage 15 Oil well/Gas well
 3 Watertight sewer lines 6 Seepage pit 9 Feedyard 12 Fertilizer storage 16 Other (specify below)
 13 Insecticide storage
 Direction from well? N How many feet? Will be 50+

FROM	TO	LITHOLOGIC LOG	FROM	TO	PLUGGING INTERVALS
<u>0</u>	<u>3</u>	<u>Clay</u>			
<u>3</u>	<u>28</u>	<u>lime</u>			
<u>28</u>	<u>52</u>	<u>Yellow Shale + Mixed lime</u>			
<u>52</u>	<u>60</u>	<u>Gray Shale</u>			
<u>60</u>	<u>75</u>	<u>lime</u>			
<u>75</u>	<u>122</u>	<u>Gray Rock</u>			
<u>122</u>	<u>123</u>	<u>Water</u>			
<u>123</u>	<u>140</u>	<u>Gray Rock + Blue Shale</u>			

7 CONTRACTOR'S OR LANDOWNER'S CERTIFICATION: This water well was (1) constructed, (2) reconstructed, or (3) plugged under my jurisdiction and was completed on (mo/day/year) 11-20-89 and this record is true to the best of my knowledge and belief. Kansas Water Well Contractor's License No. 180 This Water Well Record was completed on (mo/day/yr) 11-30-89 under the business name of Backhus Drilling by (signature) Paul V. Backhus

OFFICE USE ONLY