


1 LOCATION OF WATER WELL: County: Morris Fraction: SW 1/4 NE 1/4 NW 1/4 Section Number: 35 Township Number: T 14 S Range Number: R 6 EW

Distance and direction from nearest town or city street address of well if located within city?
Dwight Fuel Services - Adolf 3 MacKenzi, White City, KS

2 WATER WELL OWNER: KDTR Time 3 Materials Board of Agriculture, Division of Water Resources
 RR#, St. Address, Box #: Forbes Field Application Number:
 City, State, ZIP Code: Topeka, KS 66620-0001

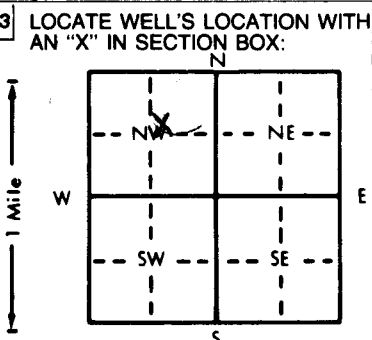

4 DEPTH OF COMPLETED WELL: 114 ft. ELEVATION: _____
 Depth(s) Groundwater Encountered 1. ~95 ft. 2. _____ ft. 3. _____ ft.
 WELL'S STATIC WATER LEVEL 72.32 ft. below land surface measured on mo/day/yr 10/27/99
 Pump test data: Well water was _____ ft. after _____ hours pumping _____ gpm
 Est. Yield _____ gpm: Well water was _____ ft. after _____ hours pumping _____ gpm
 Bore Hole Diameter: 8.75 in. to 114 ft., and _____ in. to _____ ft.
 WELL WATER TO BE USED AS:
 5 Public water supply 8 Air conditioning 11 Injection well
 1 Domestic 3 Feedlot 6 Oil field water supply 9 Dewatering 12 Other (Specify below)
 2 Irrigation 4 Industrial 7 Lawn and garden only 10 Monitoring well MW-1
 Was a chemical/bacteriological sample submitted to Department? Yes _____ No X; If yes, mo/day/yr sample was submitted _____
 Water Well Disinfected? Yes _____ No X

5 TYPE OF BLANK CASING USED:
 1 Steel 3 RMP (SR) 5 Wrought iron 8 Concrete tile CASING JOINTS: Glued _____ Clamped _____
 2 PVC 3 4 ABS 6 Asbestos-Cement 9 Other (specify below) Welded _____
 Blank casing diameter 4 in. to 6.4 ft., Dia _____ in. to _____ ft., Dia _____ in. to _____ ft.
 Casing height above land surface: flush in., weight See 40 lbs./ft. Wall thickness or gauge No. _____
 TYPE OF SCREEN OR PERFORATION MATERIAL:
 1 Steel 3 Stainless steel 5 Fiberglass 7 PVC 10 Asbestos-cement
 2 Brass 4 Galvanized steel 6 Concrete tile 8 RMP (SR) 11 Other (specify) _____
 9 ABS 12 None used (open hole)
 SCREEN OR PERFORATION OPENINGS ARE:
 1 Continuous slot 3 Mill slot 5 Gauzed wrapped 8 Saw cut 11 None (open hole)
 2 Louvered shutter 4 Key punched 6 Wire wrapped 9 Drilled holes
 7 Torch cut 10 Other (specify) _____
 SCREEN-PERFORATED INTERVALS: From 6.4 ft. to 114 ft., From _____ ft. to _____ ft.
 From _____ ft. to _____ ft., From _____ ft. to _____ ft.
 From _____ ft. to _____ ft., From _____ ft. to _____ ft.
 SCREEN-PERFORATED INTERVALS: From 6.3 ft. to 114 ft., From _____ ft. to _____ ft.
 From _____ ft. to _____ ft., From _____ ft. to _____ ft.

6 GROUT MATERIAL: 1 Neat cement 2 Cement grout 3 Bentonite 4 Other _____
 Grout Intervals: 3 From 6.3 ft. to 6.1 ft. 2 From 6.1 ft. to 0 ft. From _____ ft. to _____ ft.
 What is the nearest source of possible contamination:
 1 Septic tank 4 Lateral lines 7 Pit privy 10 Livestock pens 14 Abandoned water well
 2 Sewer lines 5 Cess pool 8 Sewage lagoon 11 Fuel storage 15 Oil well/Gas well
 3 Watertight sewer lines 6 Seepage pit 9 Feedyard 12 Fertilizer storage 16 Other (specify below)
Contaminated site
 Direction from well? _____ How many feet? _____

FROM	TO	LITHOLOGIC LOG	FROM	TO	PLUGGING INTERVALS
0	2	soil			
2	11	silty clay			
11	13	Limestone			
13	26 26	shale			
26 26	28	Limestone			
28	75	shale			
75	80	Limestone			
80	96	shale			
96	99	Limestone w/ shale			
99	114	Limestone			
114	TD	end of borehole			

7 CONTRACTOR'S OR LANDOWNER'S CERTIFICATION: This water well was 1 constructed, (2) reconstructed, or (3) plugged under my jurisdiction and was completed on (mo/day/year) 10/20/99 and this record is true to the best of my knowledge and belief. Kansas Water Well Contractor's License No. 585 This Water Well Record was completed on (mo/day/yr) 10/27/99 under the business name of AEI by (signature) A. Duncan & D. Duncan

OFFICE USE ONLY
T
R
EW
SEC.