


1 LOCATION OF WATER WELL: County: Morris Fraction: SW 1/4 NE 1/4 NW 1/4 Section Number: 35 Township Number: T 14 S Range Number: R 6 EW

Distance and direction from nearest town or city street address of well if located within city?  
Dwight Fuel Services - Adolf & Mac Kenzi - White City, KS.

2 WATER WELL OWNER: KDHE - BER - Time & Materials  
RR#, St. Address, Box #: Forbes Field  
City, State, ZIP Code: Topeka, KS 66620-0001  
Board of Agriculture, Division of Water Resources  
Application Number:

3 LOCATE WELL'S LOCATION WITH AN "X" IN SECTION BOX:

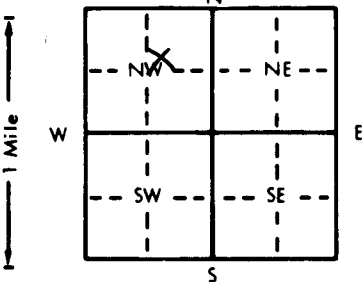

4 DEPTH OF COMPLETED WELL: 108.5 ft. ELEVATION: .....  
Depth(s) Groundwater Encountered 1. ~95 ft. 2. .... ft. 3. .... ft.  
WELL'S STATIC WATER LEVEL 72.50 ft. below land surface measured on mo/day/yr 10/27/99  
Pump test data: Well water was ..... ft. after ..... hours pumping ..... gpm  
Est. Yield ..... gpm Well water was ..... ft. after ..... hours pumping ..... gpm  
Bore Hole Diameter 8.75 in. to 108.5 ft., and ..... in. to ..... ft.  
WELL WATER TO BE USED AS:  
5 Public water supply 8 Air conditioning 11 Injection well  
1 Domestic 3 Feedlot 6 Oil field water supply 9 Dewatering 12 Other (Specify below)  
2 Irrigation 4 Industrial 7 Lawn and garden only  Monitoring well MW-2  
Was a chemical/bacteriological sample submitted to Department? Yes ..... No X ..... If yes, mo/day/yr sample was submitted  
Water Well Disinfected? Yes ..... No X

5 TYPE OF BLANK CASING USED:  
1 Steel 3 RMP (SR) 5 Wrought iron 8 Concrete tile CASING JOINTS: Glued ..... Clamped .....  
 PVC 4 ABS 6 Asbestos-Cement 9 Other (specify below) Welded .....  
7 Fiberglass Threaded X

Blank casing diameter 4 in. to 58.5 ft., Dia ..... in. to ..... ft., Dia ..... in. to ..... ft.  
Casing height above land surface Flush in., weight ..... lbs./ft. Wall thickness or gauge No. ....

TYPE OF SCREEN OR PERFORATION MATERIAL:  
1 Steel 3 Stainless steel 5 Fiberglass 8 RMP (SR) 10 Asbestos-cement  
2 Brass 4 Galvanized steel 6 Concrete tile 9 ABS 11 Other (specify) .....  
12 None used (open hole)

SCREEN OR PERFORATION OPENINGS ARE:  
1 Continuous slot  Mill slot 5 Gauzed wrapped 8 Saw cut 11 None (open hole)  
2 Louvered shutter 4 Key punched 6 Wire wrapped 9 Drilled holes  
7 Torch cut 10 Other (specify) .....

SCREEN-PERFORATED INTERVALS: From 108.5 ft. to 58.5 ft., From ..... ft. to ..... ft.  
From ..... ft. to ..... ft., From ..... ft. to ..... ft.  
GRAVEL PACK INTERVALS: From 108.5 ft. to 57.5 ft., From ..... ft. to ..... ft.  
From ..... ft. to ..... ft., From ..... ft. to ..... ft.

6 GROUT MATERIAL: 1 Neat cement  Cement grout  Bentonite 4 Other .....  
Grout Intervals  From 57.5 ft. to 55.5 ft.  From 55.5 ft. to 0 ft., From ..... ft. to ..... ft.

What is the nearest source of possible contamination:  
1 Septic tank 4 Lateral lines 7 Pit privy 11 Fuel storage 14 Abandoned water well  
2 Sewer lines 5 Cess pool 8 Sewage lagoon 12 Fertilizer storage 15 Oil well/Gas well  
3 Watertight sewer lines 6 Seepage pit 9 Feedyard 13 Insecticide storage  Other (specify below)  
contaminated site

Direction from well? How many feet?

FROM	TO	LITHOLOGIC LOG	FROM	TO	PLUGGING INTERVALS
0	12	<u>silty clay</u>			
12	23	<u>shale</u>			
23	25	<u>Limestone</u>			
25	74	<u>shale</u>			
74	79	<u>Limestone</u>			
79	89	<u>shale</u>			
89	108.5	<u>Limestone</u>			
108.5	TD	<u>end of borehole</u>			

7 CONTRACTOR'S OR LANDOWNER'S CERTIFICATION: This water well was  constructed, (2) reconstructed, or (3) plugged under my jurisdiction and was completed on (mo/day/year) 10/20/99 and this record is true to the best of my knowledge and belief. Kansas Water Well Contractor's License No. 585 This Water Well Record was completed on (mo/day/yr) 10/27/99 under the business name of AEI by (signature) A. Duncan Sr. Duncan

OFFICE USE ONLY  
T  
R  
EW  
SEC.