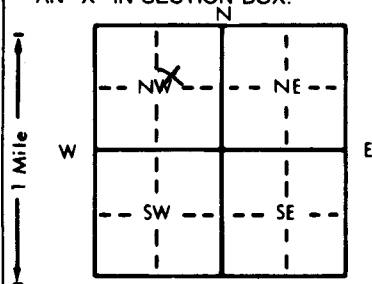


MW-3

1 LOCATION OF WATER WELL: County: Morris Fraction: SW 1/4 NE 1/4 NW 1/4 Section Number: 35 Township Number: T 14 S Range Number: R 6 EW

Distance and direction from nearest town or city street address of well if located within city?
Dwight Fuel Services - Adoff 3 Mackenzi - White City, KS

2 WATER WELL OWNER: KDIE-BER - Time 3 Materials
 RR#, St. Address, Box #: Forbes Field, Bldg 740
 City, State, ZIP Code: Topeka, KS 66620-0001
 Board of Agriculture, Division of Water Resources
 Application Number:

3 LOCATE WELL'S LOCATION WITH AN "X" IN SECTION BOX:

 4 DEPTH OF COMPLETED WELL: 110 ft. ELEVATION:
 Depth(s) Groundwater Encountered 1. ~96 ft. 2. ft. 3. ft.
 WELL'S STATIC WATER LEVEL: 71.68 ft. below land surface measured on 10/27/99
 Pump test data: Well water was ft. after hours pumping gpm
 Est. Yield 0 gpm: Well water was ft. after hours pumping gpm
 Bore Hole Diameter: 8.75 in. to 110 ft., and in. to ft.
 WELL WATER TO BE USED AS:
 5 Public water supply 8 Air conditioning 11 Injection well
 1 Domestic 3 Feedlot 6 Oil field water supply 9 Dewatering
 2 Irrigation 4 Industrial 7 Lawn and garden only 10 Monitoring well MW-3
 12 Other (Specify below)
 Was a chemical/bacteriological sample submitted to Department? Yes No X; If yes, mo/day/yr sample was submitted
 Water Well Disinfected? Yes No X

5 TYPE OF BLANK CASING USED:
 1 Steel 3 RMP (SR) 5 Wrought iron 8 Concrete tile CASING JOINTS: Glued Clamped
 2 PVC 4 ABS 6 Asbestos-Cement 9 Other (specify below) Welded
 7 Fiberglass Threaded X
 Blank casing diameter 4 in. to 60 ft., Dia. in. to ft., Dia. in. to ft.
 Casing height above land surface Flush in., weight Sch 40 lbs./ft. Wall thickness or gauge No.
 TYPE OF SCREEN OR PERFORATION MATERIAL:
 1 Steel 3 Stainless steel 5 Fiberglass 8 RMP (SR) 10 Asbestos-cement
 2 Brass 4 Galvanized steel 6 Concrete tile 9 ABS 11 Other (specify)
 12 None used (open hole)
 SCREEN OR PERFORATION OPENINGS ARE:
 1 Continuous slot 3 Mill slot 5 Gauzed wrapped 8 Saw cut 11 None (open hole)
 2 Louvered shutter 4 Key punched 6 Wire wrapped 9 Drilled holes
 7 Torch cut 10 Other (specify)
 SCREEN-PERFORATED INTERVALS: From 60 ft. to 110 ft., From ft. to ft.
 From ft. to ft., From ft. to ft.
 GRAVEL PACK INTERVALS: From 59 ft. to 110 ft., From ft. to ft.
 From ft. to ft., From ft. to ft.

6 GROUT MATERIAL: 1 Neat cement 2 Cement grout 3 Bentonite 4 Other
 Grout Intervals 3 From 59 ft. to 57 ft. 2 From 57 ft. to 0 ft., From ft. to ft.
 What is the nearest source of possible contamination:
 1 Septic tank 4 Lateral lines 7 Pit privy 10 Livestock pens 14 Abandoned water well
 2 Sewer lines 5 Cess pool 8 Sewage lagoon 11 Fuel storage 15 Oil well/Gas well
 3 Watertight sewer lines 6 Seepage pit 9 Feedyard 12 Fertilizer storage 16 Other (specify below)
contaminated site
 13 Insecticide storage
 Direction from well? How many feet?

FROM	TO	LITHOLOGIC LOG	FROM	TO	PLUGGING INTERVALS
0	7	alt clay			
7	23	shale			
23	25	limestone			
25	95	shale			
95	110	limestone			
110	TD	end of borehole			

7 CONTRACTOR'S OR LANDOWNER'S CERTIFICATION: This water well was 1 constructed, (2) reconstructed, or (3) plugged under my jurisdiction and was completed on (mo/day/year) 10/21/99 and this record is true to the best of my knowledge and belief. Kansas Water Well Contractor's License No. 585 This Water Well Record was completed on (mo/day/yr) 10/27/99 under the business name of FEI by (signature) Aduncan for DDu

OFFICE USE ONLY

T

R

EW

SEC.

1/4

1/4

1/4