


1 LOCATION OF WATER WELL: Fraction SW 1/4 NE 1/4 NW 1/4 Section Number 35 Township Number T 14 S Range Number R 6 W
 County: Morris

Distance and direction from nearest town or city street address of well if located within city?
Dwight Fuel Service - Adolf Mackenzi - White City, KS

2 WATER WELL OWNER: KDHE-BER - Time 3 Materials
 RR#, St. Address, Box #: Forbes Field, Bldg 740
 City, State, ZIP Code: Topeka, KS 66620-0001
 Board of Agriculture, Division of Water Resources
 Application Number:

3 LOCATE WELL'S LOCATION WITH AN "X" IN SECTION BOX:

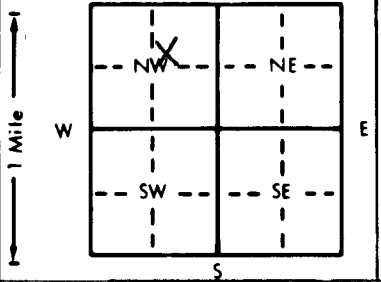

4 DEPTH OF COMPLETED WELL: 114 ft. ELEVATION: ft.
 Depth(s) Groundwater Encountered 1 ~ 102 ft. 2. ft. 3. ft.
 WELL'S STATIC WATER LEVEL: 71.45 ft. below land surface measured on 10/27/99
 Pump test data: Well water was ft. after hours pumping gpm
 Est. Yield gpm: Well water was ft. after hours pumping gpm
 Bore Hole Diameter: 8.625 in. to 114 in. to in. to ft.

WELL WATER TO BE USED AS:
 1 Domestic 3 Feedlot 6 Oil field water supply 9 Dewatering 12 Other (Specify below)
 2 Irrigation 4 Industrial 7 Lawn and garden only 10 Monitoring well MW-4
 Was a chemical/bacteriological sample submitted to Department? Yes.....No X.....; If yes, mo/day/yr sample was submitted
 Water Well Disinfected? Yes No X

5 TYPE OF BLANK CASING USED:
 1 Steel 3 RMP (SR) 5 Wrought iron 8 Concrete tile CASING JOINTS: Glued Clamped
2 PVC 4 ABS 7 Fiberglass Welded
 Blank casing diameter 4 in. to 64 ft., Dia in. to ft., Dia in. to ft.
 Casing height above land surface: Flush in., weight sch 40 lbs./ft. Wall thickness or gauge No.

TYPE OF SCREEN OR PERFORATION MATERIAL:
 1 Steel 3 Stainless steel 5 Fiberglass 7 PVC 10 Asbestos-cement
 2 Brass 4 Galvanized steel 6 Concrete tile 9 ABS 11 Other (specify)
 12 None used (open hole)

SCREEN OR PERFORATION OPENINGS ARE:
 1 Continuous slot 3 Mill slot 5 Gauzed wrapped 8 Saw cut 11 None (open hole)
 2 Louvered shutter 4 Key punched 6 Wire wrapped 9 Drilled holes
 7 Torch cut 10 Other (specify)

SCREEN-PERFORATED INTERVALS: From 114 ft. to 64 ft., From ft. to ft.
 From ft. to ft., From ft. to ft.
SAND
 GRAVEL PACK INTERVALS: From 114 ft. to 63 ft., From ft. to ft.
 From ft. to ft., From ft. to ft.

6 GROUT MATERIAL: 1 Neat cement 2 Cement grout 3 Bentonite 4 Other
 Grout Intervals 3 From 63 ft. to 61 ft. 2 From 61 ft. to 0 ft., From ft. to ft.
 What is the nearest source of possible contamination:
 1 Septic tank 4 Lateral lines 7 Pit privy 10 Livestock pens 14 Abandoned water well
 2 Sewer lines 5 Cess pool 8 Sewage lagoon 11 Fuel storage 15 Oil well/Gas well
 3 Watertight sewer lines 6 Seepage pit 9 Feedyard 12 Fertilizer storage 16 Other (specify below) contaminated site
 13 Insecticide storage

Direction from well? How many feet?

| FROM | TO | LITHOLOGIC LOG | FROM | TO | PLUGGING INTERVALS |
|------|-----|-------------------------|------|----|--------------------|
| 0 | 1 | SOIL | | | |
| 1 | 6 | SILTY CLAY | | | |
| 6 | 22 | Shale | | | |
| 22 | 24 | Limestone | | | |
| 24 | 67 | Shale | | | |
| 67 | 96 | Shale w/ some limestone | | | |
| 96 | 110 | Limestone | | | |
| 110 | TD | end of borehole | | | |

7 CONTRACTOR'S OR LANDOWNER'S CERTIFICATION: This water well was 1 constructed, (2) reconstructed, or (3) plugged under my jurisdiction and was completed on (mo/day/year) 10/20/99 and this record is true to the best of my knowledge and belief. Kansas Water Well Contractor's License No. 585 This Water Well Record was completed on (mo/day/yr) 10/27/99 under the business name of AEI by (signature) A. Duncan D. Dan

INSTRUCTIONS: Use typewriter or ball point pen. PLEASE PRESS FIRMLY and PRINT clearly. Please fill in blanks, underline or circle the correct answers. Send top three copies to Kansas Department of Health and Environment, Bureau of Water, Topeka, Kansas 66620-0001. Telephone: 913-296-5545. Send one to WATER WELL OWNER and retain one for your records.

OFFICE USE ONLY
T
R
EW
SEC.
1/4
1/4
1/4