


1 LOCATION OF WATER WELL: Fraction SE 1/4 SE 1/4 NW 1/4 Section Number 5 Township Number T 14 S Range Number R 6 E
 County: Morris

Distance and direction from nearest town or city street address of well if located within city? 1 N Skiddy
106 Fox Creek Rd.

2 WATER WELL OWNER: Albert G. Woods CO PERMIT
 RR#, St. Address, Box #: 106 Fox Creek Rd. Board of Agriculture, Division of Water Resources
 City, State, ZIP Code: White City, KS. 66872 Application Number:

3 LOCATE WELL'S LOCATION WITH AN "X" IN SECTION BOX: 4 DEPTH OF COMPLETED WELL: 80 ft. ELEVATION:

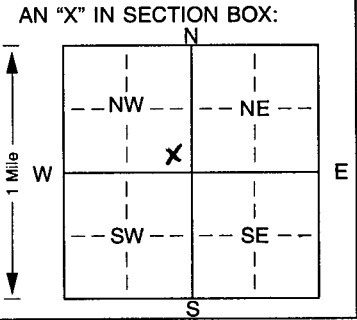

Depth(s) Groundwater Encountered 1, 25 ft. 2. ft. 3. ft.
 WELL'S STATIC WATER LEVEL: 25 ft. below land surface measured on mo/day/yr

Pump test data: Well water was ft. after hours pumping gpm
 Est. Yield 1/2 gpm; Well water was ft. after hours pumping gpm
 Bore Hole Diameter: 9 in. to 80 ft., and in. to ft.

WELL WATER TO BE USED AS: 5 Public water supply 8 Air conditioning 11 Injection well
1 Domestic 3 Feedlot 6 Oil field water supply 9 Dewatering 12 Other (Specify below)
 2 Irrigation 4 Industrial 7 Domestic (lawn & garden) 10 Monitoring well

Was a chemical/bacteriological sample submitted to Department? Yes. No.; If yes, mo/day/yr sample was sub-
 mitted Water Well Disinfected? Yes No

5 TYPE OF BLANK CASING USED: 5 Wrought iron 8 Concrete tile CASING JOINTS: Glued Clamped.
 1 Steel 3 RMP (SR) 6 Asbestos-Cement 9 Other (specify below) Welded

Blank casing diameter: 5 in. to 60 ft., Dia in. to ft., Dia in. to ft.
 Casing height above land surface: 2' in., weight 5ch 40 lbs./ft. Wall thickness or gauge No.

TYPE OF SCREEN OR PERFORATION MATERIAL: PVC 10 Asbestos-cement
 1 Steel 3 Stainless steel 5 Fiberglass 8 RMP (SR) 11 Other (specify)

SCREEN OR PERFORATION OPENINGS ARE: 5 Gauzed wrapped 8 Saw cut 11 None (open hole)
 1 Continuous slot 3 Mill slot 25 6 Wire wrapped 9 Drilled holes
 2 Louvered shutter 4 Key punched 1500 7 Torch cut 10 Other (specify)

SCREEN-PERFORATED INTERVALS: From 60 ft. to 80 ft., From ft. to ft.
 From ft. to ft., From ft. to ft.
 GRAVEL PACK INTERVALS: From 25 ft. to 80 ft., From ft. to ft.
 From ft. to ft., From ft. to ft.

6 GROUT MATERIAL: 1 Neat cement 2 Cement grout 3 Bentonite 4 Other

Grout Intervals: From 0 ft. to 25 ft., From ft. to ft., From ft. to ft.
 What is the nearest source of possible contamination:
 1 Septic tank 4 Lateral lines 7 Pit privy 10 Livestock pens 14 Abandoned water well
 2 Sewer lines 5 Cess pool 8 Sewage lagoon 11 Fuel storage 15 Oil well/Gas well
 3 Watertight sewer lines 6 Seepage pit 9 Feedyard 12 Fertilizer storage 16 Other (specify below)
 13 Insecticide storage

Direction from well? South How many feet? 100

FROM	TO	LITHOLOGIC LOG	FROM	TO	PLUGGING INTERVALS
<u>0</u>	<u>1</u>	<u>Top Soil</u>			
<u>1</u>	<u>23</u>	<u>Brown clay</u>			
<u>23</u>	<u>25</u>	<u>Limestone + Gravel (water)</u>			
<u>25</u>	<u>30</u>	<u>Blue Gray Shale (Oily + Sticky)</u>			
<u>30</u>	<u>35</u>	<u>Limestone (water)</u>			
<u>35</u>	<u>57</u>	<u>Gray shale</u>			
<u>57</u>	<u>68</u>	<u>Limestone</u>			
<u>68</u>	<u>80</u>	<u>Blue Gray Shale (Oily + Sticky)</u>			

7 CONTRACTOR'S OR LANDOWNER'S CERTIFICATION: This water well was (1) constructed, (2) reconstructed, or (3) plugged under my jurisdiction and was completed on (mo/day/year) 9/29/2000 and this record is true to the best of my knowledge and belief. Kansas Water Well Contractor's Licence No. 1451 This Water Well Record was completed on (mo/day/yr) 10/10/2000 under the business name of Haldeman Well Drilling by (signature) Craig Haldeman