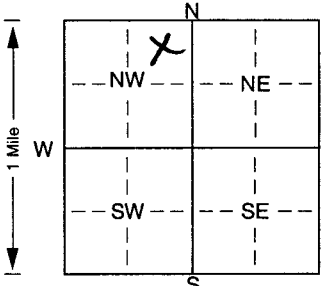


1] LOCATION OF WATER WELL: Fraction NE 1/4 NE 1/4 NW 1/4 Section Number 35 Township Number T 14 S Range Number R 6 E
 County: Morris

Distance and direction from nearest town or city street address of well if located within city?
Adolph & Mackenzie, Whitecity Kansas 66872

2] WATER WELL OWNER: Dwight Fuel Service
 RR#, St. Address, Box #: P.O. Box 98
 City, State, ZIP Code: Dwight Kansas 66847-12
 Board of Agriculture, Division of Water Resources
 Application Number: 1472.37

3] LOCATE WELL'S LOCATION WITHIN SECTION BOX: AN "X" IN SECTION BOX:

 DEPTH OF COMPLETED WELL: 712 ft. ELEVATION: 1472.37
 Depth(s) Groundwater Encountered: 9.35 - 9.0 ft. 2. ft. 3. ft.
 WELL'S STATIC WATER LEVEL: 9.35 ft. below land surface measured on mo/day/yr 3/25/02
 Pump test data: Well water was ft. after hours pumping gpm
 Est. Yield gpm: Well water was ft. after hours pumping gpm
 Bore Hole Diameter: 8.25 in. to 11.4 in. to in. to in.
 WELL WATER TO BE USED AS:
 5 Public water supply 8 Air conditioning 11 Injection well
 1 Domestic 3 Feedlot 6 Oil field water supply 9 Dewatering 12 Other (Specify below)
 2 Irrigation 4 Industrial 7 Domestic (lawn & garden) 6 Monitoring well
 * Was a chemical/bacteriological sample submitted to Department? Yes. No X; If yes, mo/day/yr sample was submitted
 Water Well Disinfected? Yes No X

5] TYPE OF BLANK CASING USED:
 1 Steel 3 RMP (SR) 6 Asbestos-Cement 9 Other (specify below) Welded
2 PVC 4 ABS 7 Fiberglass Threaded PVC
 Blank casing diameter 10.206 in. to 7.2 in. Dia in. to in. Dia in. to in.
 Casing height above land surface: 6.60 in., weight 0.8 lbs./ft. Wall thickness or gauge No. SH 40
 TYPE OF SCREEN OR PERFORATION MATERIAL:
 1 Steel 3 Stainless steel 5 Fiberglass 8 RMP (SR) 10 Asbestos-cement
 2 Brass 4 Galvanized steel 6 Concrete tile 9 ABS 11 Other (specify)
 12 None used (open hole)
 SCREEN OR PERFORATION OPENINGS ARE:
 1 Continuous slot 2 Mill slot 5 Gauzed wrapped 8 Saw cut 11 None (open hole)
 2 Louvered shutter 4 Key punched 6 Wire wrapped 9 Drilled holes
 7 Torch cut 10 Other (specify) ft.
 SCREEN-PERFORATED INTERVALS: From 72 ft. to 112 ft., From ft. to ft.
 From ft. to ft., From ft. to ft.
 GRAVEL PACK INTERVALS: From 68 ft. to 114 ft., From ft. to ft.
 From ft. to ft., From ft. to ft.

6] GROUT MATERIAL: 1 Neat cement 2 Cement grout 3 Bentonite 4 Other
 Grout Intervals: From 1 ft. to 68 ft., From ft. to ft., From ft. to ft.
 What is the nearest source of possible contamination:
 1 Septic tank 4 Lateral lines 7 Pit privy 10 Livestock pens 14 Abandoned water well
 2 Sewer lines 5 Cess pool 8 Sewage lagoon 11 Fuel storage 15 Oil well/Gas well
 3 Watertight sewer lines 6 Seepage pit 9 Feedyard 12 Fertilizer storage 16 Other (specify below)
LAST SITE
 Direction from well? How many feet?

FROM	TO	LITHOLOGIC LOG	FROM	TO	PLUGGING INTERVALS
0'	2'	Crushed Rock			
2'	10'	Clay, brown, silty, dense, high plasticity			
10'	12'	Limestone tan			
12'	25'	Shale, yellow			
25'	30'	*clear quartz pieces in? Limestone, gray			
30'	65'	Shale, gray			
65'	68'	Limestone, gray			
68'	82'	Shale - green			
82'	112'	Limestone - green			
<u>6</u>	<u>102</u>	Fractures			

7] CONTRACTOR'S OR LANDOWNER'S CERTIFICATION: This water well was (1) constructed, (2) reconstructed, or (3) plugged under my jurisdiction and was completed on (mo/day/year) 03/06/02 and this record is true to the best of my knowledge and belief. Kansas Water Well Contractor's Licence No. 594 This Water Well Record was completed on (mo/day/yr) under the business name of Coranco Great Plains by (signature) [Signature]