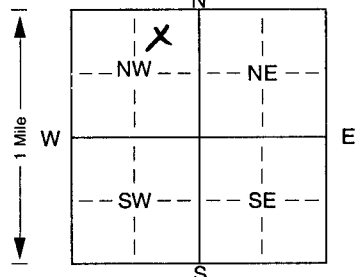


1 LOCATION OF WATER WELL: Fraction NW 1/4 NE 1/4 NW 1/4 Section Number 35 Township Number T 14 S Range Number R 6 E
 County: MORRIS

Distance and direction from nearest town or city street address of well if located within city?
Adolph + Mackenzie White City Kansas 66872

2 WATER WELL OWNER: Dwight Fuel Service
 RR#, St. Address, Box #: P.O. Box 98
 City, State, ZIP Code: Dwight Kansas 66847
 Board of Agriculture, Division of Water Resources
 Application Number: 1470.90

3 LOCATE WELL'S LOCATION WITH AN "X" IN SECTION BOX:

 4 DEPTH OF COMPLETED WELL: 110 ft. ELEVATION: 1470.90 ft.
 Depth(s) Groundwater Encountered: 1.5 ft. 2. 90 ft. 3. 90 ft.
 WELL'S STATIC WATER LEVEL: 89.45 ft. below land surface measured on mo/day/yr 03/25/02
 Pump test data: Well water was _____ ft. after _____ hours pumping _____ gpm
 Est. Yield _____ gpm: Well water was _____ ft. after _____ hours pumping _____ gpm
 Bore Hole Diameter: 8.25 in. to 110 ft. and _____ in. to _____ ft.
 WELL WATER TO BE USED AS:
 1 Domestic 3 Feedlot 6 Oil field water supply 8 Air conditioning 11 Injection well
 2 Irrigation 4 Industrial 7 Domestic (lawn & garden) 9 Dewatering 12 Other (Specify below)
 Was a chemical/bacteriological sample submitted to Department? Yes. (No) X; If yes, mo/day/yr sample was submitted
 Water Well Disinfected? Yes (No) X

5 TYPE OF BLANK CASING USED:
 1 Steel 3 RMP (SR) 5 Wrought iron 8 Concrete tile CASING JOINTS: Glued _____ Clamped _____
 2 PVC 4 ABS 6 Asbestos-Cement 9 Other (specify below) Welded _____
(2) PVC 7 Fiberglass Threaded PVC
 Blank casing diameter 10.206 in. to 70 ft. Dia _____ in. to _____ ft. Dia _____ in. to _____ ft.
 Casing height above land surface 4.12 in. weight 0.8 lbs./ft. Wall thickness or gauge No. 59440
 TYPE OF SCREEN OR PERFORATION MATERIAL: PVC
 1 Steel 3 Stainless steel 5 Fiberglass 8 RMP (SR) 10 Asbestos-cement
 2 Brass 4 Galvanized steel 6 Concrete tile 9 ABS 11 Other (specify) _____
 12 None used (open hole)
 SCREEN OR PERFORATION OPENINGS ARE:
 1 Continuous slot 2 Mill slot 3 Key punched 4 Saw cut 5 Gauzed wrapped 6 Wire wrapped 7 Drilled holes 8 None (open hole)
 2 Louvered shutter 4 Key punched 10 Other (specify) _____ ft.
 SCREEN-PERFORATED INTERVALS: From 70 ft. to 110 ft. From _____ ft. to _____ ft.
 From _____ ft. to _____ ft. From _____ ft. to _____ ft.
 GRAVEL PACK INTERVALS: From 65 ft. to 110 ft. From _____ ft. to _____ ft.
 From _____ ft. to _____ ft. From _____ ft. to _____ ft.

6 GROUT MATERIAL: 1 Neat cement 2 Cement grout 3 Bentonite 4 Other _____
 Grout Intervals: From 1 ft. to 65 ft. From _____ ft. to _____ ft. From _____ ft. to _____ ft.
 What is the nearest source of possible contamination:
 1 Septic tank 4 Lateral lines 7 Pit privy 10 Livestock pens 14 Abandoned water well
 2 Sewer lines 5 Cess pool 8 Sewage lagoon 11 Fuel storage 15 Oil well/Gas well
 3 Watertight sewer lines 6 Seepage pit 9 Feedyard 12 Fertilizer storage 16 Other (specify below) DUST SITE
 13 Insecticide storage
 Direction from well? _____ How many feet? _____

FROM	TO	LITHOLOGIC LOG	FROM	TO	PLUGGING INTERVALS
01	4'	Soil, dark, brown			
4'	11'	clay, brown, silty			
		dense, high plasticity.			
11'	14'	Limestone, yellow			
14'	28'	Shale, yellow.			
28'	32'	Limestone, gray			
32'	37'	Shale - gray			
37'	42'	Limestone, gray			
42'	68'	Shale - reddish			
		brown			
68'	110'	Limestone - green.			

7 CONTRACTOR'S OR LANDOWNER'S CERTIFICATION: This water well was (1) constructed, (2) reconstructed, or (3) plugged under my jurisdiction and was completed on (mo/day/year) 03/12/02 and this record is true to the best of my knowledge and belief. Kansas Water Well Contractor's Licence No. 594 This Water Well Record was completed on (mo/day/yr) 05/02/02 under the business name of Coranco Great Plains by (signature) [Signature]