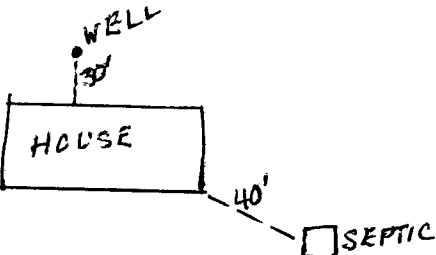


USE TYPEWRITER OR BALL
POINT PEN-PRESS FIRMLY,
PRINT CLEARLY.

WATER WELL RECORD
KSA 82a-1201-1215

Kansas Department of Health and
Environment-Division of Environment
(Water well Contractors)
Topeka, Kansas 66620

1. Location of well:		County Morris	Fraction SW 1/4 NW 1/4 NW 1/4	Section number 214	Township number T 14 S R 6	Range number 6
2. Distance and direction from nearest town or city: Street address of well location if in city: 13/4 N → White City		3. Owner of well: Herbert Newmeyer R.R. or street: R.R. # 2 City, state, zip code: White City, Kans.				
4. Locate with "X" in section below: N W E S 1 Mile		Sketch map: 		6. Bore hole dia. 8 in. Completion date 2/16/77 Well depth 96 ft.		
5. Type and color of material		From	To	7. <input checked="" type="checkbox"/> Cable tool <input type="checkbox"/> Rotary <input type="checkbox"/> Driven <input type="checkbox"/> Dug <input type="checkbox"/> Hollow rod <input type="checkbox"/> Jetted <input type="checkbox"/> Bored <input type="checkbox"/> Reverse rotary		
Yellow clay and rock 20'		0	20	8. Use: <input checked="" type="checkbox"/> Domestic <input type="checkbox"/> Public supply <input type="checkbox"/> Industry <input type="checkbox"/> Irrigation <input type="checkbox"/> Air conditioning <input type="checkbox"/> Stock <input type="checkbox"/> Lawn <input type="checkbox"/> Oil field water <input type="checkbox"/> Other		
Red clay 28'		20	48	9. Casing: Material plst Height: Above or below *** Threaded <input type="checkbox"/> Welded gl Surface 18 in. RMP <input checked="" type="checkbox"/> PVC <input type="checkbox"/> Weight <input type="checkbox"/> lbs./ft. Dia. 5 in. to 96 ft. depth Wall Thickness: inches or Dia. <input type="checkbox"/> in. to <input type="checkbox"/> ft. depth gage No. 0.258		
Yellow clay and limestone 20'		48	68	10. Screen: Manufacturer's name Western Plastics Type RMP Dia. 5 1/2 Slot/gauze 3/32 Length 20' Set between 76 ft. and 96 ft. Gravel pack? Yes Size range of material 1/16 to 3/8		
Limestone and hollow 15'		76	91	11. Static water level: 76 ft. below land surface Date 2/16/77 ma./day/yr.		
Blue gray shale 6'		91	96	12. Pumping level below land surfaces: ____ ft. after ____ hrs. pumping ____ g.p.m. ____ ft. after ____ hrs. pumping ____ g.p.m. Estimated maximum yield 16 g.p.m.		
(Use a second sheet if needed)				13. Water sample submitted: ____ mo./day/yr. <input type="checkbox"/> Yes <input checked="" type="checkbox"/> No Date ____		
				14. Well head completion: <input checked="" type="checkbox"/> Pitless adapter ____ Inches above grade		
				15. Well grouted? yes With: <input checked="" type="checkbox"/> Neat cement <input type="checkbox"/> Bentonite <input type="checkbox"/> Concrete Depth: From 3 ft. to 13 ft.		
				16. Nearest source of possible contamination: ft. 100' Direction W.E. Type Septic Well disinfected upon completion? <input checked="" type="checkbox"/> Yes <input type="checkbox"/> No		
				17. Pump: <input checked="" type="checkbox"/> Not installed Manufacturer's name ____ Model number ____ HP ____ Volts ____ Length of drop pipe ____ ft. capacity ____ g.p.m. Type: <input type="checkbox"/> Submersible <input type="checkbox"/> Turbine <input type="checkbox"/> Jet <input type="checkbox"/> Reciprocating <input type="checkbox"/> Centrifugal <input type="checkbox"/> Other		
18. Elevation:	19. Remarks:		20. Water well contractor's certification: This well was drilled under my jurisdiction and this report is true to the best of my knowledge and belief. Rader Drilling Co. 194 Business name Carlton, Kansas License No. 67429 Address Brant & Rader Date 4-2-77 Signed Authorized representative			

Forward the white, blue and pink copies to the Department of Health and Environment

Form WWC-5