

1 LOCATION OF WATER WELL: County: <u>Morris</u>	Fraction <u>SW 1/4 NW 1/4 NW 1/4</u>	Section Number <u>28</u>	Township Number <u>T 14 S</u>	Range Number <u>R 6 E</u>
--	---	-----------------------------	----------------------------------	------------------------------

Distance and direction from nearest town or city street address of well if located within city?

2W 1/2 N White City2 WATER WELL OWNER: Larry Dittman

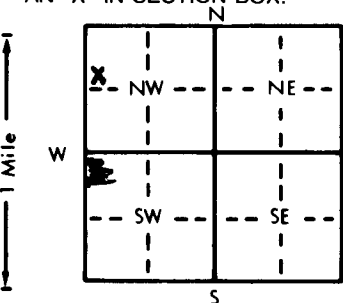
RR#, St. Address, Box # :

City, State, ZIP Code : White City, KS. 66872

Board of Agriculture, Division of Water Resources

Application Number:

3 LOCATE WELL'S LOCATION WITH AN "X" IN SECTION BOX:

4 DEPTH OF COMPLETED WELL: 92 ft.

ELEVATION:

Depth(s) Groundwater Encountered 1. 40 ft. 2. 78 ft. 3. 92 ft.WELL'S STATIC WATER LEVEL 20 ft. below land surface measured on mo/day/yr 5-14-84

Pump test data: Well water was \_\_\_\_\_ ft. after \_\_\_\_\_ hours pumping \_\_\_\_\_ gpm

Est. Yield 40 gpm Well water was \_\_\_\_\_ ft. after \_\_\_\_\_ hours pumping \_\_\_\_\_ gpmBore Hole Diameter 9 in. to 15 in. and 7 in. to 95 in.

WELL WATER TO BE USED AS: 5 Public water supply 8 Air conditioning 11 Injection well

1 Domestic 3 Feedlot 6 Oil field water supply 9 Dewatering 12 Other (Specify below)

2 Irrigation 4 Industrial 7 Lawn and garden only 10 Observation well

Was a chemical/bacteriological sample submitted to Department? Yes \_\_\_\_\_ No X If yes, mo/day/yr sample was submitted \_\_\_\_\_Water Well Disinfected? Yes X No

5 TYPE OF BLANK CASING USED:

1 Steel 3 RMP (SR)

2 PVC 4 ABS

5 Wrought iron

8 Concrete tile

CASING JOINTS: Glued X Clamped \_\_\_\_\_

6 Asbestos-Cement

9 Other (specify below)

Welded \_\_\_\_\_

7 Fiberglass

Threaded \_\_\_\_\_

Blank casing diameter 5 in. to 35 in. Dia 5 in. to 72 in. Dia \_\_\_\_\_ in. to \_\_\_\_\_ in.Casing height above land surface 15 in., weight 12.85 lbs./ft. Wall thickness or gauge No. 2.14

TYPE OF SCREEN OR PERFORATION MATERIAL:

1 Steel 3 Stainless steel

2 Brass 4 Galvanized steel

5 Fiberglass

6 Concrete tile

7 PVC

8 RMP (SR)

10 Asbestos-cement

11 Other (specify) \_\_\_\_\_

9 ABS

12 None used (open hole)

SCREEN OR PERFORATION OPENINGS ARE:

1 Continuous slot 3 Mill slot

2 Louvered shutter 4 Key punched

5 Gauzed wrapped

6 Wire wrapped

7 Torch cut 458 Saw cut

9 Drilled holes

10 Other (specify) \_\_\_\_\_

11 None (open hole)

SCREEN-PERFORATED INTERVALS: From 35 ft. to 45 ft., From \_\_\_\_\_ ft. to \_\_\_\_\_ ft.From 72 ft. to 92 ft., From \_\_\_\_\_ ft. to \_\_\_\_\_ ft.GRAVEL PACK INTERVALS: From 10 ft. to 92 ft., From \_\_\_\_\_ ft. to \_\_\_\_\_ ft.

From \_\_\_\_\_ ft. to \_\_\_\_\_ ft., From \_\_\_\_\_ ft. to \_\_\_\_\_ ft.

6 GROUT MATERIAL:

1 Neat cement

2 Cement grout

3 Bentonite

4 Other \_\_\_\_\_

Grout Intervals: From 0 ft. to 10 ft., From \_\_\_\_\_ ft. to \_\_\_\_\_ ft., From \_\_\_\_\_ ft. to \_\_\_\_\_ ft.

What is the nearest source of possible contamination:

1 Septic tank

4 Lateral lines

7 Pit privy

10 Livestock pens

14 Abandoned water well

2 Sewer lines

5 Cess pool

8 Sewage lagoon

11 Fuel storage

15 Oil well/Gas well

3 Watertight sewer lines 6 Seepage pit

9 Feedyard

12 Fertilizer storage

16 Other (specify below)

13 Insecticide storage

Direction from well? N EHow many feet? 75

FROM	TO	LITHOLOGIC LOG	FROM	TO	LITHOLOGIC LOG
0	3	Top Soil			
3	40	Shale + Lime Stone			
40	41	Some Water			
41	78	Gray Rock			
78	79	Water			
79	92	Gray Rock			

7 CONTRACTOR'S OR LANDOWNER'S CERTIFICATION: This water well was (1) constructed, (2) reconstructed, or (3) plugged under my jurisdiction and was completed on (mo/day/year) 5-14-84 and this record is true to the best of my knowledge and belief. Kansas Water Well Contractor's License No. 120 This Water Well Record was completed on (mo/day/yr) 5-14-84under the business name of Backhus Drilling by (signature) Paul Backhus

INSTRUCTIONS: Use typewriter or ball point pen, PLEASE PRESS FIRMLY and PRINT clearly. Please fill in blanks, underline or circle the correct answers. Send top three copies to Kansas Department of Health and Environment, Division of Environment, Environmental Geology Section, Topeka, KS 66620. Send one to WATER WELL OWNER and retain one for your records.