


☒ Original Record    ☐ Correction    ☐ Change in Well Use

Well ID

**MW7**[illegible]

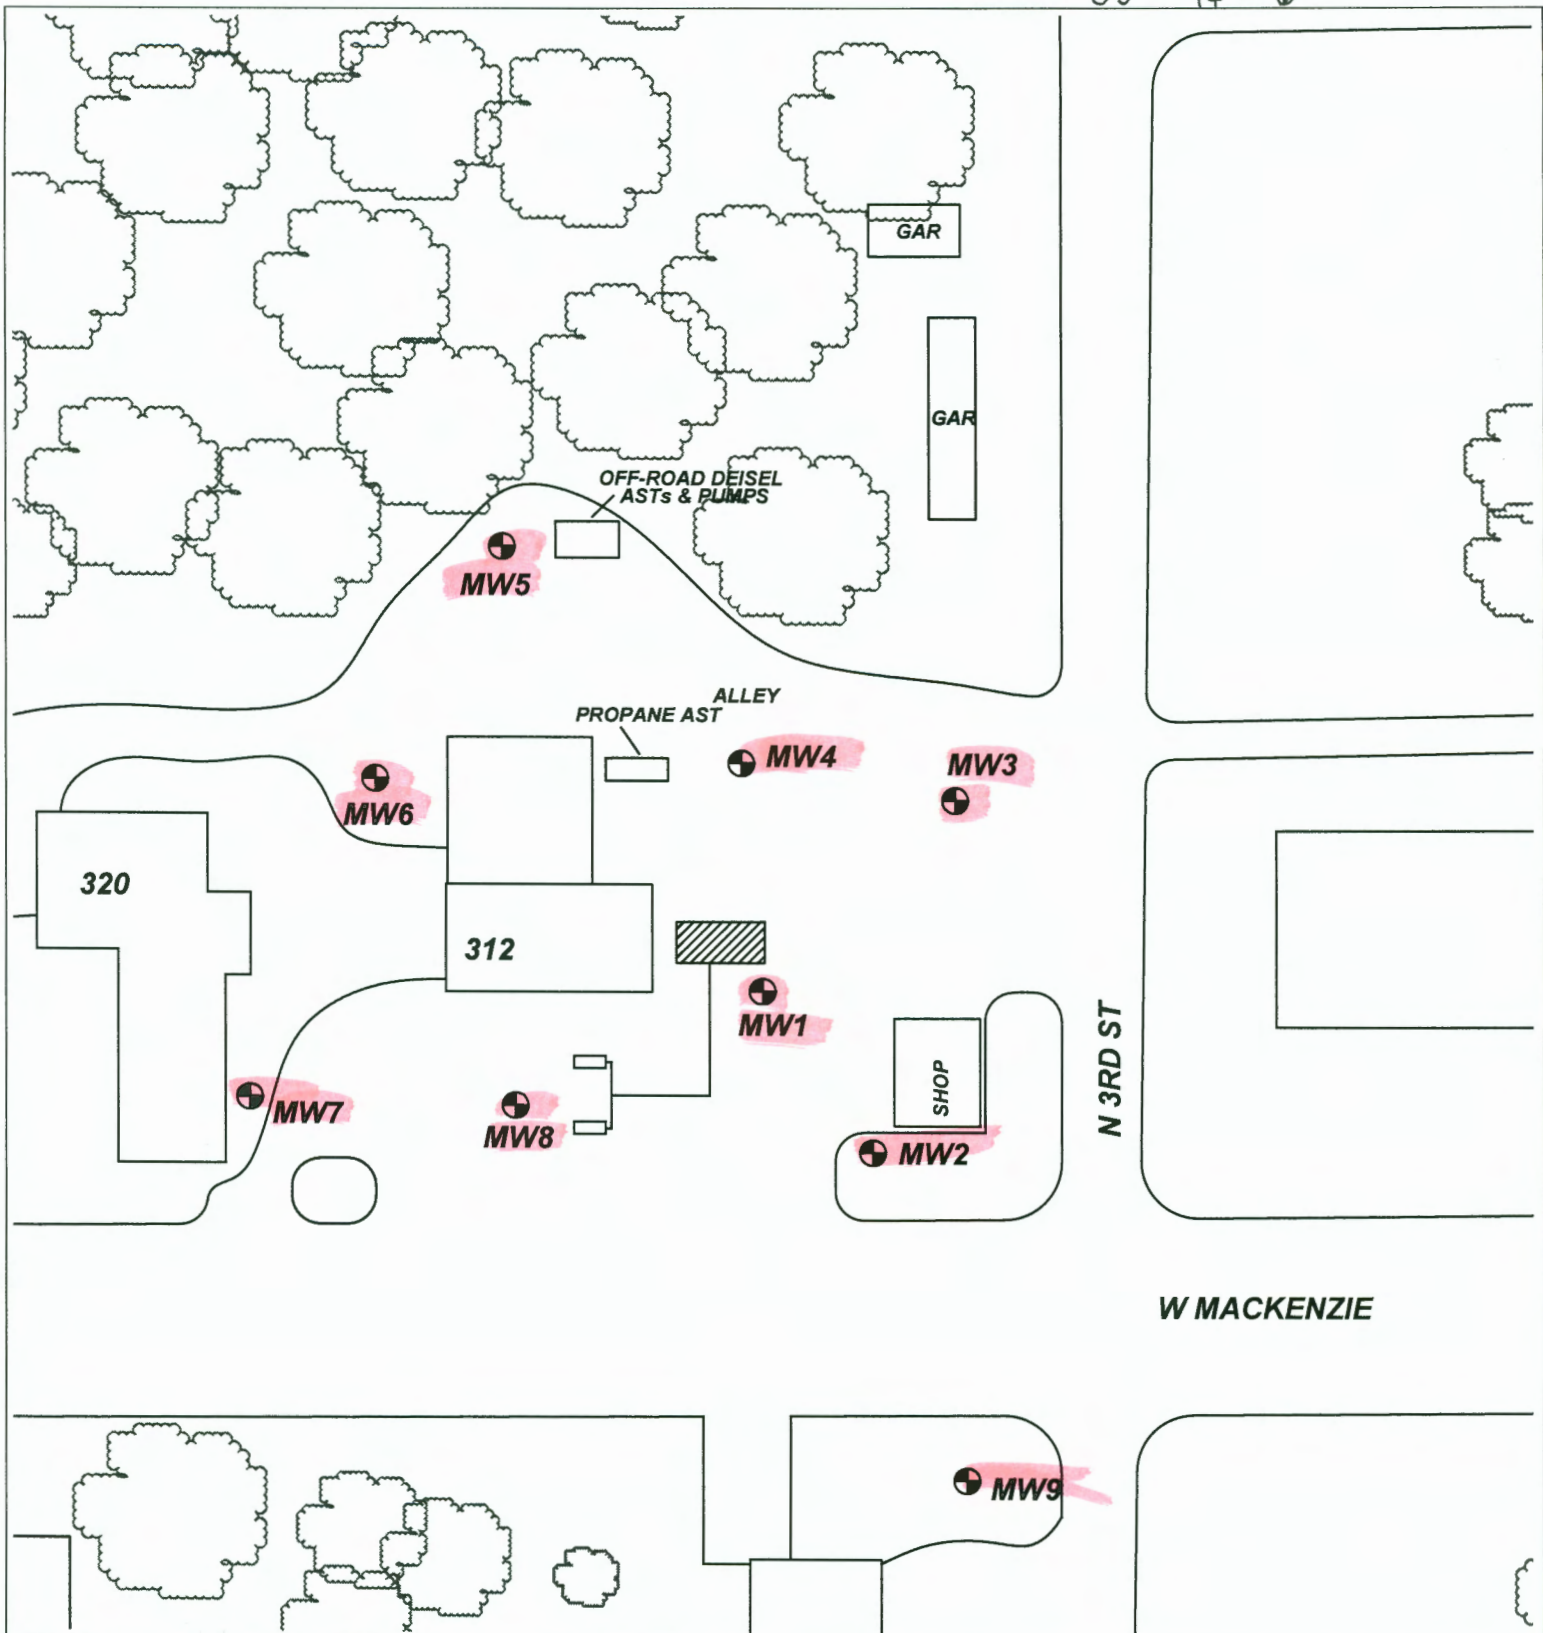

PROJECT: **AGRI TRAILS COOP - WHITE CITY**

ADDRESS: **312 MACKENZIE ST.**

LOCATION: **WHITE CITY, KS**

DRAWN BY: **B. STALNAKER** DATE: **5/27/20**

REVISED BY: **B. STALNAKER** DATE: **12/14/20**

AEI JOB #: **TF528** KDHE JOB #: **U5-064-15220**

TITLE:



**ASSOCIATED  
ENVIRONMENTAL  
INC.**

LEGEND:

- = ACTIVE PUMP ISLAND/BASIN
- = MONITORING WELL

..... = SUBJECT PROPERTY

SCALE: **1" = 50'**



0 25 50

NOTES:

