

☒ Original Record    ☐ Correction    ☐ Change in Well Use


Well ID

**MW1**

**11 CONTRACTOR'S OR LANDOWNER'S CERTIFICATION:** This water well was ☒ constructed, ☐ reconstructed, or ☐ plugged under my jurisdiction and was completed on (mo-day-year) 9/22/20 ..... and this record is true to the best of my knowledge and belief. Kansas Water Well Contractor's License No. 585 ..... This Water Well Record was completed on (mo-day-year) 10/19/20 ..... under the business name of ASSOCIATED ENVIRONMENTAL, INC. ..... Signature [Signature] .....

Visit us at <http://www.kdheks.gov/waterwell/index.html>

**Revised 7/10/2015**

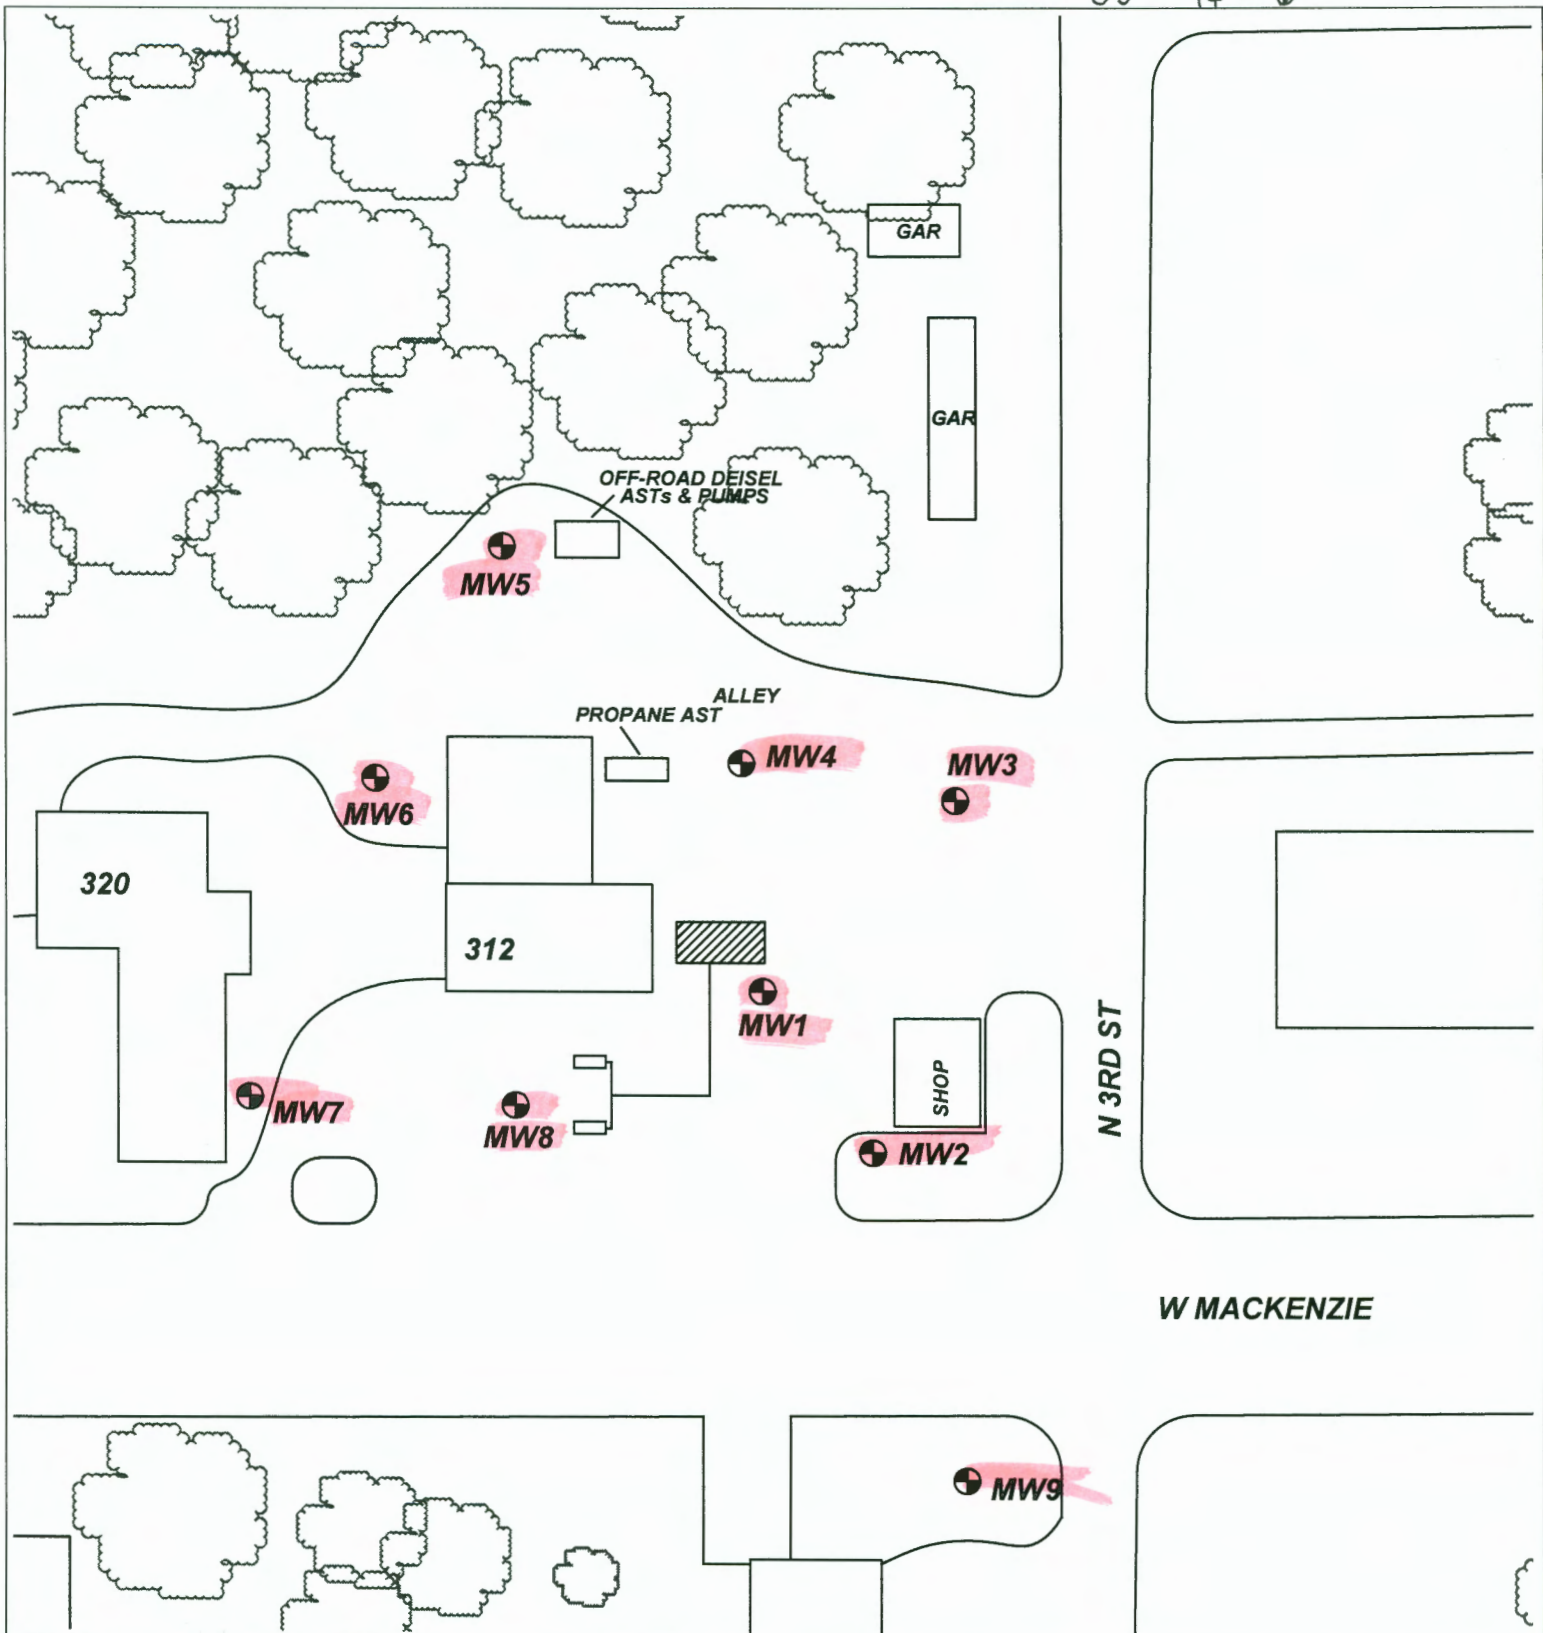

PROJECT: **AGRI TRAILS COOP - WHITE CITY**

ADDRESS: **312 MACKENZIE ST.**

LOCATION: **WHITE CITY, KS**

DRAWN BY: **B. STALNAKER** DATE: **5/27/20**

REVISED BY: **B. STALNAKER** DATE: **12/14/20**

AEI JOB #: **TF528** KOHE JOB #: **U5-064-15220**

TITLE:



**ASSOCIATED  
ENVIRONMENTAL  
INC.**

LEGEND:

- = ACTIVE PUMP ISLAND/BASIN
- = MONITORING WELL

..... = SUBJECT PROPERTY

SCALE: **1" = 50'**



0 25 50

NOTES:

