


1 LOCATION OF WATER WELL: Fraction  $\frac{1}{4}$  NE  $\frac{1}{4}$  NW  $\frac{1}{4}$  Section Number 12 Township Number T 14 S Range Number R 7 E

Distance and direction from nearest town or city street address of well if located within city? From Dwight  $\frac{1}{2}$  mile North on Highway 57 then  $\frac{1}{2}$  mile West

2 WATER WELL OWNER: Carlos Buckals  
 RR#, St. Address, Box #: 1012 Highland Dr.  
 City, State, ZIP Code: Junction City, Kansas 66441  
 Board of Agriculture, Division of Water Resources  
 Application Number:

3 LOCATE WELL'S LOCATION WITH AN "X" IN SECTION BOX:

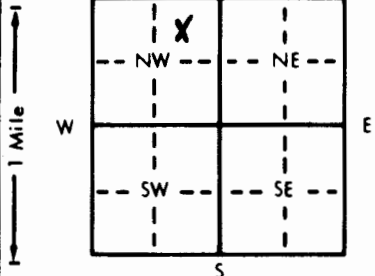

4 DEPTH OF COMPLETED WELL: 80 ft. ELEVATION: ... ft.

Depth(s) Groundwater Encountered 1. 53 ft. 2. ... ft. 3. ... ft.  
 WELL'S STATIC WATER LEVEL: 50 ft. below land surface measured on mo/day/yr  
 Pump test data: Well water was ... ft. after ... hours pumping ... gpm  
 Est. Yield: 15 gpm; Well water was ... ft. after ... hours pumping ... gpm  
 Bore Hole Diameter: 8 in. to 80 in. to ... in. to ... in. to ... ft.  
 WELL WATER TO BE USED AS:  
 1 Domestic (circled) 3 Feedlot 6 Oil field water supply 9 Dewatering 12 Other (Specify below)  
 2 Irrigation 4 Industrial 7 Lawn and garden only 10 Monitoring well  
 Was a chemical/bacteriological sample submitted to Department? Yes ... No ...; If yes, mo/day/yr sample was submitted  
 Water Well Disinfected? Yes (circled) No

5 TYPE OF BLANK CASING USED:  
 1 Steel (circled) 3 RMP (SR) 5 Wrought iron 8 Concrete tile CASING JOINTS: Slued (circled) & Seamed (circled) Clamped ...  
 2 PVC (circled) 4 ABS 6 Asbestos-Cement 9 Other (specify below) Welded ...  
 Blank casing diameter: 5 in. to 60 ft., Dia. ... in. to ... ft., Dia. ... in. to ... ft.  
 Casing height above land surface: 2 in., weight: Sch 40 lbs./ft. Wall thickness or gauge No. ...

TYPE OF SCREEN OR PERFORATION MATERIAL:  
 1 Steel 3 Stainless steel 5 Fiberglass 7 PVC (circled) 10 Asbestos-cement  
 2 Brass 4 Galvanized steel 6 Concrete tile 8 RMP (SR) 11 Other (specify) ...  
 9 ABS 12 None used (open hole)

SCREEN OR PERFORATION OPENINGS ARE:  
 1 Continuous slot 3 Mill slot (circled) 31/1000 (circled) 5 Gauzed wrapped 8 Saw cut 11 None (open hole)  
 2 Louvered shutter 4 Key punched 6 Wire wrapped 9 Drilled holes  
 7 Torch cut 10 Other (specify) ...

SCREEN-PERFORATED INTERVALS: From 60 ft. to 80 ft. From ... ft. to ... ft.  
 GRAVEL PACK INTERVALS: From 20 ft. to 80 ft. From ... ft. to ... ft.

6 GROUT MATERIAL: 1 Neat cement 2 Cement grout 3 Bentonite (circled) 4 Other ...  
 Grout intervals: From 0 ft. to 20 ft. From ... ft. to ... ft.

What is the nearest source of possible contamination:  
 1 Septic tank 4 Lateral lines (circled) 7 Pit privy 10 Livestock pens 14 Abandoned water well  
 2 Sewer lines 5 Cess pool 8 Sewage lagoon 11 Fuel storage 15 Oil well/Gas well  
 3 Watertight sewer lines 6 Seepage pit 9 Feedyard 12 Fertilizer storage 16 Other (specify below)  
 13 Insecticide storage

Direction from well? North East How many feet? 100'

FROM	TO	LITHOLOGIC LOG	FROM	TO	PLUGGING INTERVALS
0	6	Brown Clay			
6	11	Rock			
11	16	Grey Shale			
16	21	Rock			
21	30	Grey Shale			
30	33	Rock			
33	53	Grey Shale			
53	63	Rock			
63	66	Grey Shale			
66	78	Rock			
78	80	Grey Shale			

7 CONTRACTOR'S OR LANDOWNER'S CERTIFICATION: This water well was (1) constructed (circled) (2) reconstructed, or (3) plugged under my jurisdiction and was completed on (mo/day/year) 12/1/88 and this record is true to the best of my knowledge and belief. Kansas Water Well Contractor's License No. 451 This Water Well Record was completed on (mo/day/yr) 3/7/89 under the business name of Holdeman Well Drilling by (signature) Craig H.

OFFICE USE ONLY  
T  
R  
EW  
SEC.  
1/4  
1/4  
1/4