SB-3

WATER WELL RECORD Form WWC-5 KSA 82a-1212

1 LOCATION OF WATER WELL: County: MORRIS	Fraction: SE ¼ SE ¼ SE ¼	Section Number: 12	Township Number: T 14 S	Range Number: R 7 E/W

Distance and direction from nearest town or city street address of well if located within city? 7TH + MAIN DWIGHT KS

2 WATER WELL OWNER: JIM KIRKEMIHDE

RR#, St. Address, Box # : 7TH-MAIN DWIGHT, KS 66849

City, State, ZIP Code :

Board of Agriculture, Division of Water Resources Application Number:

3 LOCATE WELL'S LOCATION WITH AN "X" IN SECTION BOX:

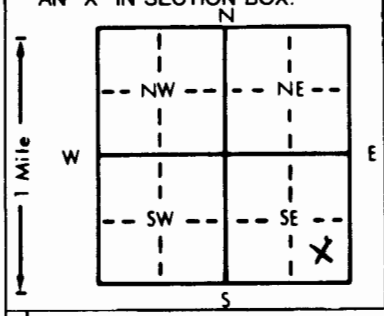

4 DEPTH OF COMPLETED WELL 33 28 ft. ELEVATION: —

Depth(s) Groundwater Encountered 1. 28 ft. 2. — ft. 3. — ft.

WELL'S STATIC WATER LEVEL NA ft. below land surface measured on mo/day/yr —

Pump test data: Well water was NA ft. after — hours pumping — gpm

Est. Yield NA gpm: Well water was — ft. after — hours pumping — gpm

Bore Hole Diameter 7.25 in. to 33 ft., and — in. to — ft.

WELL WATER TO BE USED AS: 5 Public water supply 8 Air conditioning 11 Injection well; 1 Domestic 3 Feedlot 6 Oil field water supply 9 Dewatering 12 Other (Specify below); 2 Irrigation 4 Industrial 7 Lawn and garden only 10 Monitoring well TEST WELL

Was a chemical/bacteriological sample submitted to Department? Yes — No X; If yes, mo/day/yr sample was submitted —

Water Well Disinfected? Yes — No X

5 TYPE OF BLANK CASING USED: NA 5 Wrought iron 8 Concrete tile CASING JOINTS: Glued — Clamped —

1 Steel 3 RMP (SR) 6 Asbestos-Cement 9 Other (specify below) — Welded —

2 PVC 4 ABS 7 Fiberglass Threaded —

Blank casing diameter NA in. to — ft., Dia — in. to — ft., Dia — in. to — ft.

Casing height above land surface NA in., weight — lbs./ft. Wall thickness or gauge No. —

TYPE OF SCREEN OR PERFORATION MATERIAL: NA 7 PVC 10 Asbestos-cement

1 Steel 3 Stainless steel 5 Fiberglass 8 RMP (SR) 11 Other (specify) —

2 Brass 4 Galvanized steel 6 Concrete tile 9 ABS 12 None used (open hole)

SCREEN OR PERFORATION OPENINGS ARE: NA 5 Gauzed wrapped 8 Saw cut 11 None (open hole)

1 Continuous slot 3 Mill slot 6 Wire wrapped 9 Drilled holes

2 Louvered shutter 4 Key punched 7 Torch cut 10 Other (specify) —

SCREEN-PERFORATED INTERVALS: From NA ft. to — ft., From — ft. to — ft.

From — ft. to — ft., From — ft. to — ft.

~~GRAVEL~~ SAND PACK INTERVALS: From 26 ft. to 33 ft., From — ft. to — ft.

From — ft. to — ft., From — ft. to — ft.

6 GROUT MATERIAL: 1 Neat cement 2 Cement grout 3 Bentonite 4 Other BENTONITE GROUT

Grout Intervals: From 23 ft. to 26 ft., From 16 ft. to 23 ft., From BUTTING GR ft. to 16 ft.

What is the nearest source of possible contamination: 10 Livestock pens 14 Abandoned water well

1 Septic tank 4 Lateral lines 7 Pit privy 11 Fuel storage 15 Oil well/Gas well

2 Sewer lines 5 Cess pool 8 Sewage lagoon 12 Fertilizer storage 16 Other (specify below)

3 Watertight sewer lines 6 Seepage pit 9 Feedyard 13 Insecticide storage CONTAMINATED SITE

Direction from well? — How many feet? —

FROM	TO	LITHOLOGIC LOG	FROM	TO	PLUGGING INTERVALS
0	1.75	FILL-SOIL-GRAVEL			
1.75	12	SILTY CLAY DK GY TO RED BRN.			
12	15	CLAY - BR TO TAN			
15	17	LIME			
17	19	SILTY CLAY			
19	20	L.S.			
20	21.5	SILTY CLAY			
21.5	23.5	L.S			
23.5	26	SILTY CLAY - LS GRAVEL			
26	28	L.S.			
28	29	SILTY CLAY - L.S. - COBBLES			
30	33	SILTY CLAY W/L.S. FRAGMENTS			

7 CONTRACTOR'S OR LANDOWNER'S CERTIFICATION: This water well was (1) constructed, (2) reconstructed, or (3) plugged under my jurisdiction and was completed on (mo/day/year) 06-22-93 and this record is true to the best of my knowledge and belief. Kansas Water Well Contractor's License No. 479 This Water Well Record was completed on (mo/day/yr) 07-17-93 under the business name of EBBERTS DRILLING by (signature) Morgan Ebbert

INSTRUCTIONS: Use typewriter or ball point pen. *PLEASE PRESS FIRMLY* and *PRINT* clearly. Please fill in blanks, underline or circle the correct answers. Send top three copies to Kansas Department of Health and Environment, Bureau of Water, Topeka, Kansas 66620-0001. Telephone: 913-296-5545. Send one to WATER WELL OWNER and retain one for your records.

OFFICE USE ONLY T R E/W SEC. ¼ ¼ ¼