


SB 5

1 LOCATION OF WATER WELL: Fraction *SE 1/4 SE 1/4 SE 1/4* Section Number *12* Township Number *T 14 S* Range Number *R 7 EW*
 County: *MOTTRIS*

Distance and direction from nearest town or city street address of well if located within city?
7TH AND MAIN DWIGHT KS

2 WATER WELL OWNER: *JIM KIRKE MIHDE* Board of Agriculture, Division of Water Resources
 RR#, St. Address, Box #: *7TH + MAIN CLYDE KS 66849* Application Number:
 City, State, ZIP Code:

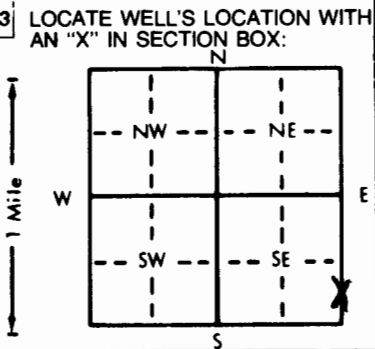

4 DEPTH OF COMPLETED WELL: *26* ft. ELEVATION: _____
 Depth(s) Groundwater Encountered 1. *NONE* ft. 2. _____ ft. 3. _____ ft.
 WELL'S STATIC WATER LEVEL: *NA* ft. below land surface measured on mo/day/yr _____
 Pump test data: Well water was _____ ft. after _____ hours pumping _____ gpm
 Est. Yield: *NA* gpm Well water was _____ ft. after _____ hours pumping _____ gpm
 Bore Hole Diameter: *7.25* in. to *26* ft. and _____ in. to _____ ft.
 WELL WATER TO BE USED AS:
 5 Public water supply 8 Air conditioning 11 Injection well
 1 Domestic 3 Feedlot 6 Oil field water supply 9 Dewatering 12 Other (Specify below)
 2 Irrigation 4 Industrial 7 Lawn and garden only 10 Monitoring well *TEST WELL*
 Was a chemical/bacteriological sample submitted to Department? Yes _____ No *X*; If yes, mo/day/yr sample was submitted _____
 Water Well Disinfected? Yes _____ No *X*

5 TYPE OF BLANK CASING USED: *NA* 5 Wrought iron 8 Concrete tile CASING JOINTS: Glued _____ Clamped _____
 1 Steel 3 RMP (SR) 6 Asbestos-Cement 9 Other (specify below) Welded _____
 2 PVC 4 ABS 7 Fiberglass Threaded _____
 Blank casing diameter _____ in. to _____ ft., Dia. _____ in. to _____ ft., Dia. _____ in. to _____ ft.
 Casing height above land surface: *NA* in., weight _____ lbs./ft. Wall thickness or gauge No. _____
 TYPE OF SCREEN OR PERFORATION MATERIAL: *NA* 7 PVC 10 Asbestos-cement
 1 Steel 3 Stainless steel 5 Fiberglass 8 RMP (SR) 11 Other (specify) _____
 2 Brass 4 Galvanized steel 6 Concrete tile 9 ABS 12 None used (open hole)
 SCREEN OR PERFORATION OPENINGS ARE: *NA* 5 Gauzed wrapped 8 Saw cut _____ 11 None (open hole)
 1 Continuous slot 3 Mill slot 6 Wire wrapped 9 Drilled holes
 2 Louvered shutter 4 Key punched 7 Torch cut 10 Other (specify) _____
 SCREEN-PERFORATED INTERVALS: From *NA* ft. to _____ ft., From _____ ft. to _____ ft.
 From _____ ft. to _____ ft., From _____ ft. to _____ ft.
 From _____ ft. to _____ ft., From _____ ft. to _____ ft.
 From _____ ft. to _____ ft., From _____ ft. to _____ ft.
 GRAVEL PACK INTERVALS: From *NA* ft. to _____ ft., From _____ ft. to _____ ft.
 From _____ ft. to _____ ft., From _____ ft. to _____ ft.

6 GROUT MATERIAL: 1 Neat cement 2 Cement grout 3 Bentonite 4 Other *SOL CUTTING*
 Grout Intervals: From *22.5* ft. to *26* ft., From *22.5* ft. to *CL* ft., From _____ ft. to _____ ft.
 What is the nearest source of possible contamination:
 1 Septic tank 4 Lateral lines 7 Pit privy 10 Livestock pens 14 Abandoned water well
 2 Sewer lines 5 Cess pool 8 Sewage lagoon 11 Fuel storage 15 Oil well/Gas well
 3 Watertight sewer lines 6 Seepage pit 9 Feedyard 12 Fertilizer storage 16 Other (specify below)
 13 Insecticide storage *CONTAMINATED SITE*
 Direction from well? _____ How many feet? _____

FROM	TO	LITHOLOGIC LOG	FROM	TO	PLUGGING INTERVALS
0	1.5	ASPHALT & GRAVEL			
1.5	9	SILTY CLAY - PETRO. UDDR			
9	16.5	CLAY - GRADES TO SILTY AT 16.5			
16.5	26	L.S. WITH SHALE AND SILTY CLAY LENSES-			

7 CONTRACTOR'S OR LANDOWNER'S CERTIFICATION: This water well was (1) constructed, (2) reconstructed, or (3) plugged under my jurisdiction and was completed on (mo/day/year) *06-28-93* and this record is true to the best of my knowledge and belief. Kansas Water Well Contractor's License No. *479* This Water Well Record was completed on (mo/day/yr) *09-17-93* under the business name of *EBBERTS DRILLING* by (signature) *Aegan Ellet*

OFFICE USE ONLY
 T
 R
 EW
 SEC.
 1/4
 1/4
 1/4