


1 LOCATION OF WATER WELL: County: MORRIS	Fraction SE 1/4 SE 1/4 SE 1/4	Section Number 5	Township Number T 14 S	Range Number R 7 E/W
--	---	----------------------------	----------------------------------	--------------------------------

Distance and direction from nearest town or city street address of well if located within city?

2 WATER WELL OWNER: RR#, St. Address, Box # : City, State, ZIP Code :	MARION HILL LUTHERAN CHURCH WHITE CITY, KS 66872	Board of Agriculture, Division of Water Resources Application Number:
---	---	--

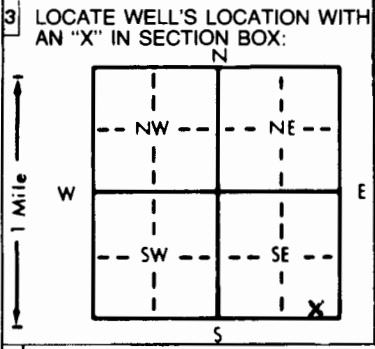

4 DEPTH OF COMPLETED WELL ft. ELEVATION: ft.
Depth(s) Groundwater Encountered 1. ft. 2. ft. 3. ft.
WELL'S STATIC WATER LEVEL ft. below land surface measured on mo/day/yr
Pump test data: Well water was ft. after hours pumping gpm
Est. Yield gpm: Well water was ft. after hours pumping gpm
Bore Hole Diameter in. to ft., and in. to ft.
WELL WATER TO BE USED AS:
5 Public water supply 8 Air conditioning 11 Injection well
1 Domestic 3 Feedlot 6 Oil field water supply 9 Dewatering 12 Other (Specify below)
2 Irrigation 4 Industrial 7 Lawn and garden only 10 Monitoring well
Was a chemical/bacteriological sample submitted to Department? Yes.....No.....; If yes, mo/day/yr sample was submitted
Water Well Disinfected? Yes No

5 TYPE OF BLANK CASING USED:	5 Wrought iron	8 Concrete tile	CASING JOINTS: Glued Clamped
1 Steel	3 RMP (SR)	6 Asbestos-Cement	9 Other (specify below)
2 PVC	4 ABS	7 Fiberglass	Welded
Blank casing diameter in. to ft., Dia in. to ft., Dia in. to ft.			Threaded
Casing height above land surface in., weight lbs./ft. Wall thickness or gauge No.			
TYPE OF SCREEN OR PERFORATION MATERIAL:		7 PVC	10 Asbestos-cement
1 Steel	3 Stainless steel	5 Fiberglass	8 RMP (SR)
2 Brass	4 Galvanized steel	6 Concrete tile	9 ABS
SCREEN OR PERFORATION OPENINGS ARE:		5 Gauzed wrapped	8 Saw cut
1 Continuous slot	3 Mill slot	6 Wire wrapped	9 Drilled holes
2 Louvered shutter	4 Key punched	7 Torch cut	10 Other (specify)
SCREEN-PERFORATED INTERVALS: From ft. to ft., From ft. to ft.			
GRAVEL PACK INTERVALS: From ft. to ft., From ft. to ft.			

6 GROUT MATERIAL:	1 Neat cement	2 Cement grout	<u>3</u> Bentonite	4 Other
Grout Intervals: From <u>3</u> ft. to <u>6</u> ft., From ft. to ft., From ft. to ft.				
What is the nearest source of possible contamination:		7 Pit privy	10 Livestock pens	14 Abandoned water well
1 Septic tank	4 Lateral lines	8 Sewage lagoon	11 Fuel storage	15 Oil well/Gas well
2 Sewer lines	5 Cess pool	9 Feedyard	12 Fertilizer storage	<u>16</u> Other (specify below)
3 Watertight sewer lines	6 Seepage pit		13 Insecticide storage	surface water
Direction from well?			How many feet?	

FROM	TO	LITHOLOGIC LOG	FROM	TO	PLUGGING INTERVALS
0	3	TOPSOIL			
			3	6	BENTONITE
6	22	SUBSOIL			
22	53	SAND			

7 CONTRACTOR'S OR LANDOWNER'S CERTIFICATION: This water well was (1) constructed, (2) reconstructed, or <u>3</u> plugged under my jurisdiction and was completed on (mo/day/year) <u>9-24-97</u> and this record is true to the best of my knowledge and belief. Kansas Water Well Contractor's License No. This Water Well Record was completed on (mo/day/year) <u>9-25-97</u> under the business name of <u>Marion Hill Lutheran Church</u> by (signature) <u>[Signature]</u>

INSTRUCTIONS: Use typewriter or ball point pen. PLEASE PRESS FIRMLY and PRINT clearly. Please fill in blanks, underline or circle the correct answers. Send top three copies to Kansas Department of Health and Environment, Bureau of Water, Topeka, Kansas 66620-0001. Telephone: 913-296-5545. Send one to WATER WELL OWNER and retain one for your records.

OFFICE USE ONLY
T
R
EW
SEC
1/4
1/4
1/4