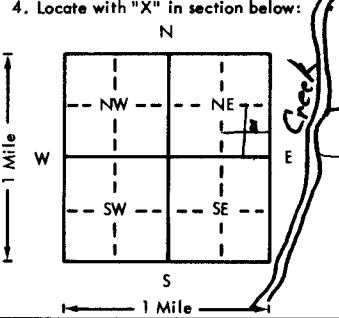
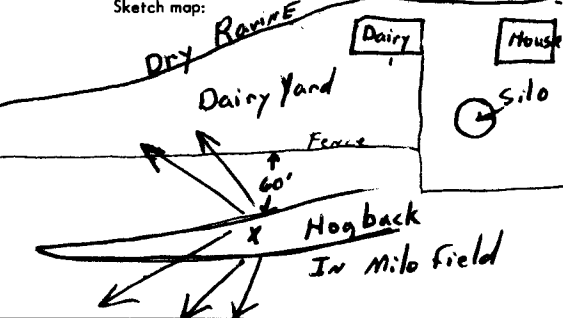


USE TYPEWRITER OR BALL POINT PEN-PRESS FIRMLY, PRINT CLEARLY.

WATER WELL RECORD
KSA 82a-1201-1215

Kansas Department of Health and Environment-Division of Environment
(Water well Contractors)
Topeka, Kansas 66620

1. Location of well: County MORRIS		Fraction NE 1/4 SE 1/4 NE 1/4		Section number E 1/2 19		Township number T 14		Range number S R 8 ①EW			
2. Distance and direction from nearest town or city: 2 E and 1/4 South of Dwight Street address of well location if in city:				3. Owner of well: Lowell Miller R.R. or street: RR Dwight, Kan City, state, zip code:							
4. Locate with "X" in section below: 				Sketch map: 				6. Bore hole dia. 6 1/2 in. Completion date 2-18-76 Well depth 120 ft.		7. <input checked="" type="checkbox"/> Cable tool <input type="checkbox"/> Rotary <input type="checkbox"/> Driven <input type="checkbox"/> Dug <input type="checkbox"/> Hollow rod <input type="checkbox"/> Jetted <input type="checkbox"/> Bored <input type="checkbox"/> Reverse rotary	
5. Type and color of material				From		To		8. Use: <input type="checkbox"/> Domestic <input type="checkbox"/> Public supply <input type="checkbox"/> Industry <input type="checkbox"/> Irrigation <input type="checkbox"/> Air conditioning <input checked="" type="checkbox"/> Stock <input type="checkbox"/> Lawn <input type="checkbox"/> Oil field water <input type="checkbox"/> Other			
Topsoil - Blk				0		6		9. Casing: Material Pits Height: Above or below Threaded <input type="checkbox"/> Welded glu Surface 24 in. RMP <input checked="" type="checkbox"/> PVC <input type="checkbox"/> Weight _____ lbs./ft. Dia. 5 in. to 16 ft. depth; Wall Thickness: inches or Dia. _____ in. to _____ ft. depth; gage No. .200			
Flint in Clay - Brn				6		14		10. Screen: Manufacturer's name Sunflower			
Sandy Silt - Very Fine Water @ 16'				14		28		Type RMP Dia. 5" <input checked="" type="checkbox"/> Slot gauge 1/8 Length 104' Set between 16 ft. and 120' ft. _____ ft. and _____ ft. Gravel pack? Yes Size range of material 1/8-1/2			
Shale - Gray				28		36		11. Static water level: _____ mo./day/yr. 16 ft. below land surface Date 2-18-76			
LIME - wht				36		40		12. Pumping level below land surfaces: 120 ft. after 34 hrs. pumping 10 g.p.m. _____ ft. after _____ hrs. pumping _____ g.p.m. Estimated maximum yield 4 g.p.m.			
Shale - Gray				40		47		13. Water sample submitted: _____ mo./day/yr. Yes <input checked="" type="checkbox"/> No <input type="checkbox"/> Date _____			
LIME - wht				47		50		14. Well head completion: <input type="checkbox"/> Pitless adapter 24 inches above grade			
Shale - Gray				50		55		15. Well grouted? Yes With: <input type="checkbox"/> Neat cement <input type="checkbox"/> Bentonite <input checked="" type="checkbox"/> Concrete Depth: From 93 ft. to 101 1/2 ft.			
Shale - Powder Blk				55		56		16. Nearest source of possible contamination: Barn yard ft. 60 Direction N Type yard Well disinfected upon completion? <input checked="" type="checkbox"/> Yes <input type="checkbox"/> No			
LIME - Gray				56		61		17. Pump: <input checked="" type="checkbox"/> Not installed Manufacturer's name Goulds Model number 7EM05412 HP 1/2 Volts 230 Length of drop pipe 116 ft. capacity 10 g.p.m. Type: <input checked="" type="checkbox"/> Submersible <input type="checkbox"/> Turbine <input type="checkbox"/> Jet <input type="checkbox"/> Reciprocating <input type="checkbox"/> Centrifugal <input type="checkbox"/> Other			
Shale - Gray				61		67		20. Water well contractor's certification: This well was drilled under my jurisdiction and this report is true to the best of my knowledge and belief. Zinn Water Well Drilling 218 Business name _____ License No. _____ Address Lost Springs, Kan Signed Joseph A. Zinn Date 2-24-76 Authorized representative			
Shale - Blk				67		69		<div style="display: flex; justify-content: space-between;"> <div style="width: 45%;"> 18. Elevation: Topography: <input type="checkbox"/> Hill <input checked="" type="checkbox"/> Slope <input type="checkbox"/> Upland <input type="checkbox"/> Valley </div> <div style="width: 45%;"> 19. Remarks: Concrete slab installed by 218 <i>No more water past 156' @ 16' looking for more and used extra depth for reservoir</i> </div> </div>			
LIME - Gray				69		70					
Shale - Gray				70		75					
LIME - Gray				67		77					
(Use a second sheet if needed)											

T 14
 R 8
 E 1/2
 Sec 19
 NE 1/4
 SE 1/4

USE TYPEWRITER OR BALL POINT PEN-PRESS FIRMLY, PRINT CLEARLY.

Cont

WATER WELL RECORD
KSA 82a-1201-1215

Kansas Department of Health and Environment-Division of Environment
(Water well Contractors)
Topeka, Kansas 66620

1. Location of well:	County Morris	Fraction NE 1/4 SE 1/4 NE 1/4	Section number EY219	Township number T 14 S R 18	Range number 18 E/W
2. Distance and direction from nearest town or city: Street address of well location if in city:			3. Owner of well: Lowell Miller R.R. or street: Continued City, state, zip code:		
4. Locate with "X" in section below: N		Sketch map:		6. Bore hole dia. _____ in. Completion date _____ Well depth _____ ft.	
		7. <input type="checkbox"/> Cable tool <input type="checkbox"/> Rotary <input type="checkbox"/> Driven <input type="checkbox"/> Dug <input type="checkbox"/> Hollow rod <input type="checkbox"/> Jetted <input type="checkbox"/> Bored <input type="checkbox"/> Reverse rotary		8. Use: <input type="checkbox"/> Domestic <input type="checkbox"/> Public supply <input type="checkbox"/> Industry <input type="checkbox"/> Irrigation <input type="checkbox"/> Air conditioning <input type="checkbox"/> Stock <input type="checkbox"/> Lawn <input type="checkbox"/> Oil field water <input type="checkbox"/> Other	
				9. Casing: Material _____ Height: Above or below Threaded _____ Welded _____ Surface _____ in. RMP _____ PVC _____ Weight _____ lbs./ft. Dia. _____ in. to _____ ft. depth Wall Thickness: inches or Dia. _____ in. to _____ ft. depth Gage No. _____	
5. Type and color of material			From	To	10. Screen: Manufacturer's name _____ Type _____ Dia. _____ Slot/gauze _____ Length _____ Set between _____ ft. and _____ ft. _____ ft. and _____ ft. Gravel pack? _____ Size range of material _____
Shale - Blu			77	80	11. Static water level: _____ mo./day/yr. _____ ft. below land surface Date _____
Shale - Gray			80	83	12. Pumping level below land surfaces: _____ ft. after _____ hrs. pumping _____ g.p.m. _____ ft. after _____ hrs. pumping _____ g.p.m. Estimated maximum yield _____ g.p.m.
LIME - Gray			83	85	13. Water sample submitted: _____ mo./day/yr. Yes _____ No _____ Date _____
Shale - Gray			85	93	14. Well head completion: _____ Pitless adapter _____ Inches above grade
LIME - Gray			93	95	15. Well grouted? _____ With: _____ Neat cement _____ Bentonite _____ Concrete Depth: From _____ ft. to _____ ft.
Shale - Powder Blu			95	97	16. Nearest source of possible contamination: ft. _____ Direction _____ Type _____ Well disinfected upon completion? _____ Yes _____ No
LIME - Wht			97	105	17. Pump: _____ Not installed Manufacturer's name _____ Model number _____ HP _____ Volts _____ Length of drop pipe _____ ft. capacity _____ g.p.m. Type: _____ Submersible _____ Turbine _____ Jet _____ Reciprocating _____ Centrifugal _____ Other
Shale - Gray			105	111	20. Water well contractor's certification: This well was drilled under my jurisdiction and this report is true to the best of my knowledge and belief. Business name _____ License No. _____ Address _____ Signed _____ Authorized representative _____ Date _____
Shale - Blk			111	120	
(Use a second sheet if needed)					
18. Elevation: Topography: ____ Hill ____ Slope ____ Upland ____ Valley	19. Remarks:				

Forward the white, blue and pink copies to the Department of Health and Environment

Form WWC-5