

WATER WELL RECORD

Form WWC-5


Division of Water Resources App. No.

1 LOCATION OF WATER WELL: County: <u>Waubunsee</u>	Fraction <u>NW 1/4 NE 1/4 SW 1/4 NE 1/4</u>	Section Number <u>2</u>	Township No. <u>T 14 S</u>	Range Number <u>R 8 E</u>
--	--	----------------------------	-------------------------------	------------------------------

Street/Rural Address of Well Location; if unknown, distance & direction from nearest town or intersection: If at owner's address, check here .
700 Main Street
Alta Vista, KS 66834

Global Positioning System (GPS) information:
 Latitude: N38.865329 (in decimal degrees)
 Longitude: W96.489464 (in decimal degrees)
 Elevation: _____
 Datum: WGS 84. NAD 83. NAD 27
 Collection Method:
 GPS unit (Make/Model: Garmin Nuvi 760)
 Digital Map/Photo, Topographic Map, Land Survey
 Est. Accuracy: <3 m, 3-5 m, 5-15 m, >15 m

2 WATER WELL OWNER:
 RR#, Street Address, Box #: KDHE-BER
1000 SW Jackson
 City, State, ZIP Code: Topeka, KS 66612

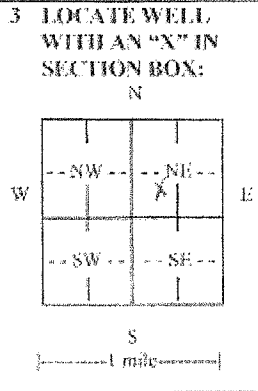

4 DEPTH OF COMPLETED WELL: 13.5 ft.

Depth(s) Groundwater Encountered (1) Dry ft. (2) N/A ft. (3) N/A ft.

WELL'S STATIC WATER LEVEL: Dry ft. below land surface measured on mo/day/yr. 2/22/2012

Pump test data: Well water was N/A ft. after N/A hours pumping, N/A gpm

EST. YIELD: N/A gpm. Well water was N/A ft. after N/A hours pumping, N/A gpm

Bore Hole Diameter 8.25 in. to 13.5 ft., and N/A in. to N/A ft.

WELL WATER TO BE USED AS: Public water supply Geothermal Injection well
 Domestic Feedlot Oil field water supply Dewatering Other (Specify below)
 Irrigation Industrial Domestic-lawn & garden Monitoring well MW-1

Was a chemical/bacteriological sample submitted to Department? Yes No
 If yes, mo/day/yr sample was submitted N/A

Water well disinfected? Yes No

5 TYPE OF CASING USED: Steel PVC Other _____

CASING JOINTS: Glued Clamped Welded Threaded

Casing diameter 2 in. to 5.5 ft., Diameter N/A in. to N/A ft., Diameter N/A in. to N/A ft.

Casing height above land surface: 0 in., Weight _____ lbs./ft., Wall thickness or gauge No. Sch 40

TYPE OF SCREEN OR PERFORATION MATERIAL:
 Steel Stainless Steel PVC Other (Specify) _____
 Brass Galvanized Steel None used (open hole)

SCREEN OR PERFORATION OPENINGS ARE:
 Continuous slot Mill slot Gauze wrapped Torch cut Drilled holes None (open hole)
 Louvered shutter Key punched Wire wrapped Saw cut Other (specify) _____

SCREEN-PERFORATED INTERVALS: From 5.5 ft. to 13.5 ft., From N/A ft. to N/A ft., From N/A ft. to N/A ft.

GRAVEL PACK INTERVALS: From 3.5 ft. to 13.5 ft., From N/A ft. to N/A ft., From N/A ft. to N/A ft.

6 GROUT MATERIAL: Neat cement Cement grout Bentonite Other Concrete from 0-2'

Grout Intervals: From 2 ft. to 3.5 ft., From N/A ft. to N/A ft., From N/A ft. to N/A ft.

What is the nearest source of possible contamination:
 Septic tank Lateral lines Pit privy Livestock pens Insecticide storage Other (specify below)
 Sewer lines Cesspool Sewage lagoon Fuel storage Abandoned water well
 Watertight sewer lines Seepage pit Feedyard Fertilizer storage Oil well/gas well

Direction from well _____ Distance from well <100ft

FROM	TO	LITHOLOGIC LOG	FROM	TO	LITHO. LOG (cont.) or PLUGGING INTERVALS
0	0.5	concrete			
0.5	3	CH: brown CLAY, damp, plastic, med.			
3	9	ML: grey, clayey SILT, damp, plastic, medium w/ LS gravels			
9	13.5	LS: weathered Limestone w/ silt			

7 CONTRACTOR'S OR LANDOWNER'S CERTIFICATION: This water well was constructed, reconstructed, or plugged under my jurisdiction and was completed on (mo/day/year) 2/22/2012 and this record is true to the best of my knowledge and belief. Kansas Water Well Contractor's License No. 759. This Water Well Record was completed on (mo/day/year) 3/4/2012 under the business name of RAZEK Environmental, LLC by (signature) [Signature]

INSTRUCTIONS: Use typewriter or ball point pen. PLEASE PRESS FIRMLY and PRINT clearly. Please fill in blanks and check the correct answers. Send three copies (white, blue, pink) to Kansas Department of Health and Environment, Bureau of Water, Geology Section, 1000 SW Jackson St., Suite 420, Topeka, Kansas 66612-1367 Telephone 785-296-5524. Send one copy to WATER WELL OWNER and retain one for your records. I include fee of \$5.00 for each constructed well. Visit us at <http://www.kdheks.gov/waterwell/index.html>