

110

Alta Vista

vjd

USE TYPEWRITER OR BALL POINT PEN-PRESS FIRMLY, PRINT CLEARLY.

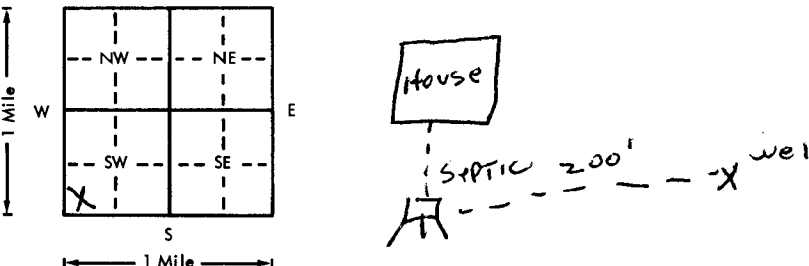
WATER WELL RECORD
KSA 82a-1201-1215

Kansas Department of Health and Environment-Division of Environment (Water well Contractors) Topeka, Kansas 66620

1. Location of well: County Wabaunsee Fraction CCC Section number 11 Township number T 1A Range number R 9 E/W

2. Distance and direction from nearest town or city: SE 15 Street address of well location if in city: OP ALTA VISTA

3. Owner of well: JANET HAND R.R. or street: City, state, zip code: RR1 ALTA VISTA, KS.

4. Locate with "X" in section below: Sketch map: 

6. Bore hole dia. 8 in. Completion date 4-12-78
Well depth 180 ft.

7. Cable tool Rotary Driven Dug
 Hollow rod Jetted Bored Reverse rotary

8. Use: Domestic Public supply Industry
 Irrigation Air conditioning Stock
 Lawn Oil field water Other

9. Casing: Material PVC Height: Above or below
Threaded Welded Surface 24 in.
RMP PVC 9L Weight 3.58 lbs./ft.
Dia. 5 in. to 180 ft. depth Wall Thickness: inches or
Dia. 5 in. to 180 ft. depth gage No. 224

5. Type and color of material	From	To
TOP SOIL	0	3
Clay, BROWN	3	13
Limestone, grey, BROWN, TAN	13	61
Shale, grey, Red	61	106
Limestone, shaly, grey	106	145
Shale, Red, Limestone, grey	145	180

10. Screen: Manufacturer's name Lumpco, MPI
Type PVC Dia. 5
Slot/gauge 0.20 Length 100'
Set between 50 ft. and 150 ft.
Gravel pack? Size range of material 0.30X.060

11. Static water level: 50 ft. below land surface Date 4-12-78 mo./day/yr.

12. Pumping level below land surfaces:
 ft. after hrs. pumping g.p.m.
 ft. after hrs. pumping g.p.m.
Estimated maximum yield 20 gpm g.p.m.

13. Water sample submitted: mo./day/yr.
Yes No Date

14. Well head completion: 24"
 Pitless adapter 24 inches above grade

15. Well grouted?
With: Neat cement Bentonite Concrete
Depth: From 0 ft. to 10 ft.

16. Nearest source of possible contamination: 200 Direction W Type SEPTIC
Well disinfected upon completion? Yes No

17. Pump: Not installed
Manufacturer's name
Model number HP Volts
Length of drop pipe ft. capacity g.p.m.
Type:
 Submersible Turbine
 Jet Reciprocating
 Centrifugal Other

18. Elevation: 1474 rm
Topography: Hill Slope Upland Valley

19. Remarks: owned to INSTALSIAB

20. Water well contractor's certification:
This well was drilled under my jurisdiction and this report is true to the best of my knowledge and belief.
STRADER DRILLING CO 182
Business name License No.
Address RT1 HOLTON, KS
Signed Dale Ashburn Date 4-14-78
Authorized representative

(Use a second sheet if needed)

1474
9
11
Subsided

Forward the white, blue and pink copies to the Department of Health and Environment

Form WWC-5