

1 LOCATION OF WATER WELL:	Fraction	Section Number	Township Number	Range Number
County: WABAUNSEE	NE 1/4 SE 1/4 NW 1/4	10	T 15 S	R 11 E

Distance and direction from nearest town or city street address of well if located within city?

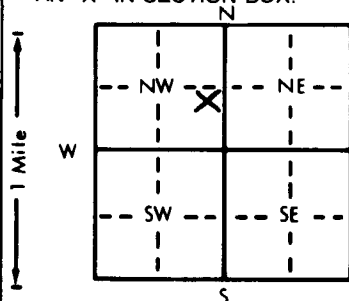
7 MILES NORTH 1/2 MILE WEST 1/4 MILE NORTH OF ALLEN KS AND HWY 562 WATER WELL OWNER: **WHEAT FARMS**RR#, St. Address, Box # : **71 BUSTER WHEAT CATTLE CO**

Board of Agriculture, Division of Water Resources

City, State, ZIP Code : **ALLEN KS 66833**

Application Number:

3 LOCATE WELL'S LOCATION WITH AN "X" IN SECTION BOX:

4 DEPTH OF COMPLETED WELL: **55' 6L** ft. ELEVATION: **SURF 10' 6L**Depth(s) Groundwater Encountered 1. **19** ft. 2. **52** ft. 3. **52** ft.WELL'S STATIC WATER LEVEL **19** ft. below land surface measured on mo/day/yr **07-05-88**Pump test data: Well water was ***** ft. after **—** hours pumping **—** gpmEst. Yield **5+** gpm. Well water was **—** ft. after **—** hours pumping **—** gpmBore Hole Diameter **8 7/8** in. to **55' 6L** ft., and **—** in. to **—** ft.

WELL WATER TO BE USED AS: 5 Public water supply 8 Air conditioning 11 Injection well

1 Domestic 3 Feedlot 6 Oil field water supply 9 Dewatering 12 Other (Specify below)

2 Irrigation 4 Industrial 7 Lawn and garden only 10 Monitoring well **HORSES**Was a chemical/bacteriological sample submitted to Department? Yes **—** No **X**; If yes, mo/day/yr sample was submitted **—**Water Well Disinfected? Yes **X** No **—**

5 TYPE OF BLANK CASING USED:

5 Wrought iron

8 Concrete tile

CASING JOINTS: Glued **X** Clamped **—**

1 Steel

3 RMP (SR)

6 Asbestos-Cement

9 Other (specify below)

Welded **—**

2 PVC

4 ABS

7 Fiberglass

Threaded **—**Blank casing diameter **5** in. to **55** ft., Dia. **—** in. to **—** ft., Dia. **—** in. to **—** ft.Casing height above land surface **12** in., weight **SCH 40** lbs./ft. Wall thickness or gauge No. **SCH 40**

TYPE OF SCREEN OR PERFORATION MATERIAL:

1 Steel

3 Stainless steel

5 Fiberglass

7 PVC

10 Asbestos-cement

2 Brass

4 Galvanized steel

6 Concrete tile

8 RMP (SR)

11 Other (specify) **—**

9 ABS

12 None used (open hole)

SCREEN OR PERFORATION OPENINGS ARE:

1 Continuous slot

3 Mill slot

5 Gauzed wrapped

8 Saw cut

11 None (open hole)

2 Louvered shutter

4 Key punched

6 Wire wrapped

9 Drilled holes

7 Torch cut

10 Other (specify) **—**SCREEN-PERFORATED INTERVALS: From **48** ft. to **55** ft., From **—** ft. to **—** ft.From **—** ft. to **—** ft., From **—** ft. to **—** ft.GRAVEL PACK INTERVALS: From **19** ft. to **55** ft., From **—** ft. to **—** ft.From **—** ft. to **—** ft., From **—** ft. to **—** ft.

6 GROUT MATERIAL:

1 Neat cement

2 Cement grout

3 Bentonite

4 Other **—**Grout Intervals: From **3** ft. to **19** ft., From **—** ft. to **—** ft., From **—** ft. to **—** ft.

What is the nearest source of possible contamination:

1 Septic tank

4 Lateral lines

7 Pit privy

10 Livestock pens

14 Abandoned water well

2 Sewer lines

5 Cess pool

8 Sewage lagoon

11 Fuel storage

15 Oil well/Gas well

3 Watertight sewer lines

6 Seepage pit

9 Feedyard

12 Fertilizer storage

16 Other (specify below)

13 Insecticide storage

HORSE PENDirection from well? **N**How many feet? **15' DOWN SLOPE**

FROM	TO	LITHOLOGIC LOG	FROM	TO	PLUGGING INTERVALS
		APPROX 2' SQ INTRANCE HOLE COVERED OAK + SHEATHING			* SL BOTH ZONES 19'
FILL		EXPANSION SEAL			
CONCRETE CEMENT		16' NEAT CEMENT			
BLK'S (WASH OUT)		1ST WATER .9 GPM - SL 10'			
APPROX 5' FT CUBE		GRAVEL PACK			* OLD WELL - NO RECORDS NO LITHOLOGIC INF. UPPER WATER IS CHARGING LOWER ZONE AT RATE OF .9 GPM - LOWER ZONE PRODUCES AT GREATER RATE WITH 4" HEND
		PVC CAP			

7 CONTRACTOR'S OR LANDOWNER'S CERTIFICATION: This water well was (1) constructed, (2) reconstructed, or (3) plugged under my jurisdiction and was completed on (mo/day/year) **07-05-88** and this record is true to the best of my knowledge and belief. KansasWater Well Contractor's License No. **479** This Water Well Record was completed on (mo/day/yr) **07-14-88**under the business name of **EBBERTS DRILLING** by (signature) **Robert Ebberts**