

CORRECTION(S) TO WATER WELL RECORD (WWC-5)

(to rectify lacking or incorrect information)

County: Osage

Location listed as:

Section-Township-Range: 11-155-14E

Fraction ($\frac{1}{4}$ $\frac{1}{4}$ $\frac{1}{4}$): None Given

Location changed to:

11-155-14E

SE SW SW SW

Other changes: Initial statements: _____

Changed to: _____

Comments: _____

verification method: written & legal descriptions, location listed on first of this series of WWC5 forms, and mapping tool on KGS website

initials: ORL date: 12/21/2005

1 LOCATION OF WATER WELL: Fraction $\frac{1}{4}$ $\frac{1}{4}$ $\frac{1}{4}$ Section Number 11 Township Number T 15 S Range Number R 14 E/W

County: Osage

Distance and direction from nearest town or city street address of well if located within city?


140 E Santa Fe, Burlingame, KS

2 WATER WELL OWNER:

RR#, St. Address, Box # : KDHE/TJM
City, State, ZIP Code : 1000 SW Jackson St. Topeka KA

Board of Agriculture, Division of Water Resources
Application Number: MW6

3 LOCATE WELL'S LOCATION WITH AN "X" IN SECTION BOX:

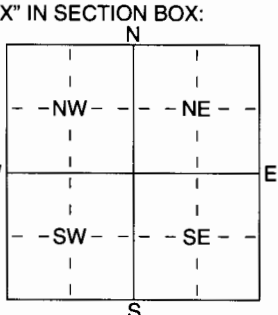

4 DEPTH OF COMPLETED WELL 15 ft. ELEVATION: 1066.26 Tol

Depth(s) Groundwater Encountered 9.83 ft. 2 ft. 3 ft.
WELL'S STATIC WATER LEVEL 1.83 ft. below land surface measured on mo/day/yr
Pump test data: Well water was ft. after hours pumping gpm
Est. Yield gpm: Well water was ft. after hours pumping gpm
WELL WATER TO BE USED AS: 5 Public water supply 8 Air conditioning 11 Injection well
1 Domestic 3 Feedlot 6 Oil field water supply 9 Dewatering 12 Other (Specify below)
2 Irrigation 4 Industrial 7 Domestic (lawn & garden) 10 Monitoring well

Was a chemical/bacteriological sample submitted to Department? Yes No ; If yes, mo/day/yr sample was submitted
Water Well Disinfected? Yes No

5 TYPE OF BLANK CASING USED:

- 1 Steel
- 2 PVC
- 3 RMP (SR)
- 4 ABS
- 5 Wrought iron
- 6 Asbestos-Cement
- 7 Fiberglass
- 8 Concrete tile
- 9 Other (specify below)

Blank casing diameter 2 in. to 5 ft., Dia in. to ft., Dia in. to ft.
Casing height above land surface 0 in., weight lbs./ft. Wall thickness or gauge No.

TYPE OF SCREEN OR PERFORATION MATERIAL:

- 1 Steel
- 2 Brass
- 3 Stainless Steel
- 4 Galvanized Steel
- 5 Fiberglass
- 6 Concrete tile
- 7 PVC
- 8 RMP (SR)
- 9 ABS
- 10 Asbestos-Cement
- 11 Other (Specify)
- 12 None used (open hole)

SCREEN OR PERFORATION OPENINGS ARE:

- 1 Continuous slot
- 2 Louvered shutter
- 3 Mill slot
- 4 Key punched
- 5 Gauzed wrapped
- 6 Wire wrapped
- 7 Torch cut
- 8 Saw cut
- 9 Drilled holes
- 10 Other (specify)
- 11 None (open hole)

SCREEN-PERFORATED INTERVALS: From 35 ft. to 15 ft., From ft. to ft.
GRAVEL PACK INTERVALS: From 3 ft. to 15 ft., From ft. to ft.

6 GROUT MATERIAL:

- 1 Neat cement
- 2 Cement grout
- 3 Bentonite
- 4 Other concrete 0-1.5

Grout Intervals: From 1.5 ft. to 3 ft., From ft. to ft., From ft. to ft.

- What is the nearest source of possible contamination:
- 1 Septic tank
 - 2 Sewer lines
 - 3 Watertight sewer lines
 - 4 Lateral lines
 - 5 Cess pool
 - 6 Seepage pit
 - 7 Pit privy
 - 8 Sewage lagoon
 - 9 Feedyard
 - 10 Livestock pens
 - 11 Fuel storage fmr
 - 12 Fertilizer storage
 - 13 Insecticide storage
 - 14 Abandoned water well
 - 15 Oil well/Gas well
 - 16 Other (specify below)

Direction from well?

FROM	TO	LITHOLOGIC LOG	FROM	TO	PLUGGING INTERVALS
0	2	clay w/ trace silt, brown mottled w/ grey soft moist rust nodules, no odor/stain			Flushmount wavier by D. Taylor
	8	clay w/ trace silt, lt tan/brown no odor, no staining wet?			
10	12	AA, wet			
	15	AA			

7 CONTRACTOR'S OR LANDOWNER'S CERTIFICATION: This water well was (1) constructed, (2) reconstructed, or (3) plugged under my jurisdiction and was completed on (mo/day/year) 9-29-05 and this record is true to the best of my knowledge and belief. Kansas

Water Well Contractor's Licence No 757 This Water Well Record was completed on (mo/day/yr) 10-22-05 under the business name of Larsen Associates, Inc. by (signature) Kelly Gunn