

USE TYPEWRITER OR BALL POINT PEN-PRESS FIRMLY, PRINT CLEARLY.

No II


WATER WELL RECORD
KSA 82a-1201-1215

T R EW sec 1/4 1/4 1/4 No.

Kansas State Dept. Of Health
(Water Well Contractors)
Forbes-Bldg. 740
Topeka, Kansas 66620

1 Location of well: County OSAGE Township name S 1/2 NW 34 Fraction 1 Section number 15 Town number 15 Range number 15

Distance and direction from nearest town or city: MILE SOUTH
MILE EAST
Street address of well location if in city: SCAMANTON KS.
3 Owner of well: WITTMER FARM REALTY INC.
Address: 1136 WANAMATER
TOPEKA KANS. 66604

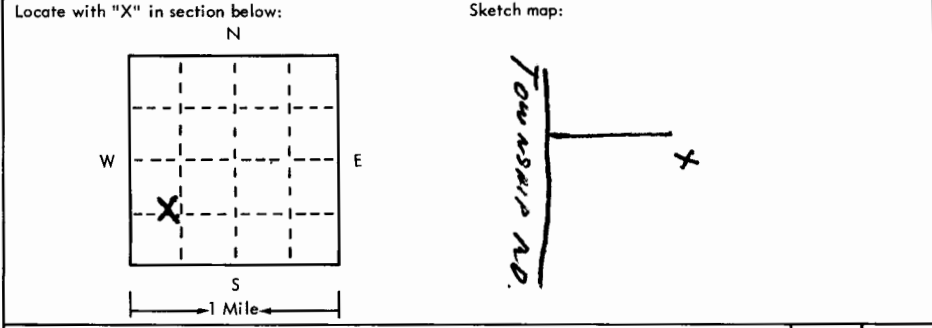

4 Well depth: 118 ft. Date of completion 7-29-76
Well diameter 5 in.

5 Cable tool Rotary Driven Dug
 Hollow rod Jetted Bored Reverse rotary

6 Use: Domestic Public supply Industry
 Irrigation Air conditioning Commercial
 Test well

7 Casing: Material STAI Height: above/below
Threaded Welded Surface 12" in.
Diam. _____ Weight _____ lbs./ft. _____
0 in. to 118 ft. depth Drive shoe? Yes No
_____ in. to _____ ft. depth!

2	Type and color of material	From	To
	SOIL	0	1
	LIME	1	12
	BROKEN LIME	12	50
	LIME HARD BLUE	50	60
	LIME BROKEN WITH SHALE LAYERS	60	90
	SHALE BLACK	90	93
	LIME	93	118
	TASTES HIGH IN CHLORIDES		
	OWNER TO POUR 4'x4'x4" SLAB.		

8 Screen: Manufacturer SHOP
Type STAI Dia. 5"
Slot/gauze 250 Length _____
Set between 90 ft. and 118 ft. _____
Fittings: Gravel pack Yes No Size range of material _____

9 Static water level: 64 ft. below land surface Date 7-29-76

10 Pumping level below land surfaces:
_____ ft. after _____ hrs. pumping _____ g.p.m.
_____ ft. after _____ hrs. pumping _____ g.p.m.
Estimated maximum yield 1000 g.p.m.

11 Water sample submitted: Yes No Date _____

12 Well head completion: Pitless adapter 12" inches above grade

13 Well grouted? Yes No
 Neat cement Bentonite _____
Depth: From 0 ft. to 18 ft.

14 Nearest source of possible contamination: _____ ft. _____ Direction UPHOLE Type _____
Well disinfected upon completion? Yes No

15 Pump: Not installed
Manufacturer's name _____
Model number _____ HP _____ Volts _____
Length of drop pipe _____ ft. capacity _____ g.m.p.
Type: Submersible Turbine
 Jet Reciprocating
 Centrifugal Other

16 Remarks: elevation

Topography:
 Hill
 Slope
 Upland
 Valley

17 Water well contractor's certification:
This well was drilled under my jurisdiction and this report is true to the best of my knowledge and belief.
JUGAIAK BROS DRILLING 119
Business name _____ License No. _____
Address WABENDALE KS
Signed [Signature] Date 7-29-76
Authorized representative

15 15E 1 NW SW