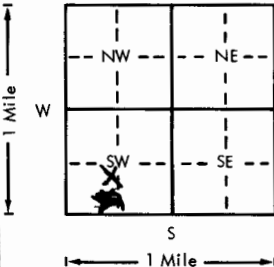
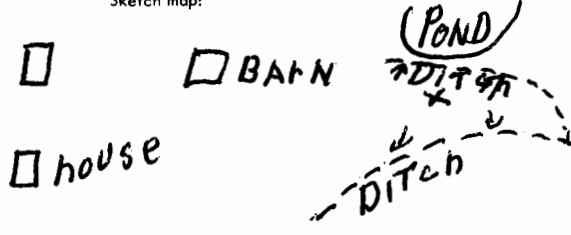


USE TYPEWRITER OR BALL
POINT PEN-PRESS FIRMLY,
PRINT CLEARLY.

WATER WELL RECORD
KSA 82a-1201-1215

Kansas Department of Health and
Environment-Division of Environment
(Water well Contractors)
Topeka, Kansas 66620

1. Location of well:		County Franklin	Fraction NE 1/4 SW 1/4 SW 1/4	Section number 29	Township number T 15 S	Range number R 18 E/W
2. Distance and direction from nearest town or city: 1 North & 3 west Street address of well location if in city: centropolis			3. Owner of well: Albert L. Robbins R.R. or street: RR 1 City, state, zip code: Pomona, Kan. 66086			
4. Locate with "X" in section below: 		Sketch map: 		6. Bore hole dia. 6 1/2 in. Completion date 9-27-77 Well depth 300 ft. 9" to 21		
5. Type and color of material		From	To	7. <input checked="" type="checkbox"/> Cable tool <input type="checkbox"/> Rotary <input type="checkbox"/> Driven <input type="checkbox"/> Dug <input type="checkbox"/> Hollow rod <input type="checkbox"/> Jetted <input type="checkbox"/> Bored <input type="checkbox"/> Reverse rotary		
slit & clay		0	10	8. Use: <input type="checkbox"/> Domestic <input type="checkbox"/> Public supply <input type="checkbox"/> Industry <input type="checkbox"/> Irrigation <input type="checkbox"/> Air conditioning <input checked="" type="checkbox"/> Stock <input type="checkbox"/> Lawn <input type="checkbox"/> Oil field water <input type="checkbox"/> Other		
grey shald		10	21	9. Casing: Material <input type="checkbox"/> Height: Above or below Threaded <input type="checkbox"/> Welded <input type="checkbox"/> Surface <input type="checkbox"/> in. RMP <input type="checkbox"/> PVC <input checked="" type="checkbox"/> Weight <input type="checkbox"/> lbs./ft. Dia. 5 in. to 283 ft. depth Wall Thickness: inches or Dia. <input type="checkbox"/> in. to <input type="checkbox"/> ft. depth gage No. 4440		
lime		21	36	10. Screen: Manufacturer's name crown line Type pvc Dia. 5 Slot/gauze 3/8 Length 60' Set between 223 ft. and 283 ft. Gravel pack? no Size range of material none		
shald		36	52	11. Static water level: 230 ft. below land surface Date 9-27-77 mo./day/yr.		
lime		52	58	12. Pumping level below land surfaces: ____ ft. after ____ hrs. pumping ____ g.p.m. ____ ft. after ____ hrs. pumping ____ g.p.m. Estimated maximum yield 13 g.p.m.		
shald		58	120	13. Water sample submitted: ____ mo./day/yr. Yes <input checked="" type="checkbox"/> No <input type="checkbox"/> Date ____		
lime		120	122	14. Well head completion: 18 inches above grade ____ Pitless adapter		
shald		122	200	15. Well grouted? <input checked="" type="checkbox"/> With: <input checked="" type="checkbox"/> Neat cement <input type="checkbox"/> Bentonite <input type="checkbox"/> Concrete Depth: From 0 ft. to 21 ft.		
lime		200	202	16. Nearest source of possible contamination: ft. ____ Direction ____ Type ____ Well disinfected upon completion? ____ Yes <input checked="" type="checkbox"/> No		
grey shald		202	230	17. Pump: Manufacturer's name Red Jacket Model number 100N1-MB6P 1 Volts 230 Length of drop pipe 290 ft. capacity 10 g.p.m. Type: <input checked="" type="checkbox"/> Submersible <input type="checkbox"/> Turbine <input type="checkbox"/> Jet <input type="checkbox"/> Reciprocating <input type="checkbox"/> Centrifugal <input type="checkbox"/> Other		
grey sand		230	240	20. Water well contractor's certification: This well was drilled under my jurisdiction and this report is true to the best of my knowledge and belief. E. SWANK DRILLING 124 Business name RA OTTAWA KAN License No. 124 Address Elmer Swank Date 12-4-77 Signed Elmer Swank authorized representative		
grey shald		240	300			
(Use a second sheet if needed)						
18. Elevation: Topography: <input type="checkbox"/> Hill <input type="checkbox"/> Slope <input checked="" type="checkbox"/> Upland <input type="checkbox"/> Valley	19. Remarks: Drilled under KS A.S.C.S. program. It was in a pasture.					

Forward the white, blue and pink copies to the Department of Health and Environment

Form WWC-5