

1	LOCATION OF WATER WELL:	Fraction	Section Number	Township Number	Range Number
County: <b>Douglas</b>	<b>NE ¼ SE ¼ SW ¼</b>	<b>17</b>	<b>T 15 S</b>	<b>R 18E E/W</b>	

Distance and direction from nearest town or city street address of well if located within city?

12 $\frac{1}{4}$  miles west 1  $\frac{3}{4}$  miles south of Baldwin


2 WATER WELL OWNER: Adrian Horne

RR#, St. Address, Box # : 6850 SW 45th  
City, State, ZIP Code : Tecumseh, Ks. 66542

Board of Agriculture, Division of Water Resources  
Application Number:

3	LOCATE WELL'S LOCATION WITH	4	DEPTH OF COMPLETED WELL ..... 380 ..... ft. ELEVATION:
---	-----------------------------	---	--------------------------------------------------------

AN "X" IN SECTION BOX:

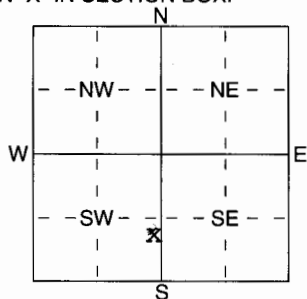

Depth(s) Groundwater Encountered 1 ..... ft. 2 ..... ft. 3 ..... ft.  
WELL'S STATIC WATER LEVEL ..... 277 ..... ft. below land surface measured on mo/day/yr ..... 5-12-04

Pump test data: Well water was ..... ft. after ..... hours pumping ..... gpm  
 Est. Yield ..... gpm: Well water was ..... ft. after ..... hours pumping ..... gpm

WELL WATER TO BE USED AS:

1 Domestic	3 Feedlot	5 Public water supply	8 Air conditioning	11 Injection well
2 Irrigation	4 Industrial	6 Oil field water supply	9 Dewatering	12 Other (Specify below)
		7 Domestic (lawn & garden)	10 Monitoring well	

Was a chemical/bacteriological sample submitted to Department? Yes ..... No X.....; If yes, mo/day/lys sample was submitted  
Water Well Disinfected? Yes X No

5	TYPE OF BLANK CASING USED:
---	----------------------------

1 Steel	3 RMP (SR)
2 PVC	4 ABS

5 Wrought iron  
6 Asbestos-Cement  
7 Fiberglass

8 Concrete tile  
9 Other (specify below)  
.....

CASING JOINTS: Glued ☒..... Clamped .....

Welded .....

Threaded .....

Blank casing diameter ..... 5 ..... in. to ..... ft., Dia ..... in. to ..... ft., Dia ..... in. to ..... ft.

Casing height above land surface ..... 24 ..... in., weight ..... 2.82 ..... lbs./ft. Wall thickness or gauge No. .... 258 .....

TYPE OF SCREEN OR PERFORATION MATERIAL:

1 Steel	3 Stainless Steel
2 Brass	4 Galvanized Steel

5 Fiberglass  
6 Concrete tile

7 PVC

8 RMP (SR)  
9 ABS

## 10 Asbestos-Cement

11 Other (Specify) .....

12 None used (open hole)

SCREEN OR PERFORATION OPENINGS ARE:

1 Continuous slot	3 Mill slot
2 Louvered shutter	4 Key punched

5 Guazed wrapped  
6 Wire wrapped  
7 Torch cut

8 Saw cut  
9 Drilled holes  
10 Other (specify) ..... ft.  
11 None (open hole)

SCREEN-PERFORATED INTERVALS: From 235 ft. to 275 ft., From 320 ft. to 380 ft.

From ..... ft. to ..... ft., From ..... ft. to ..... ft.

GRAVEL PACK INTERVALS: From 260 ft. to 380 ft., From \_\_\_\_\_ ft. to \_\_\_\_\_ ft.  
From \_\_\_\_\_ ft. to \_\_\_\_\_ ft., From \_\_\_\_\_ ft. to \_\_\_\_\_ ft.

6	GROUT MATERIAL:	1 Neat cement	2 Cement grout	3 Bentonite	4 Other .....
---	-----------------	---------------	----------------	-------------	---------------

Grout Intervals: From 0 ft. to 24 ft., From 240 ft. to 260 ft., From \_\_\_\_\_ ft. to \_\_\_\_\_ ft.

What is the nearest source of possible contamination:

1 Septic tank	<u>4 Lateral lines</u>
2 Sewer lines	5 Cess pool
3 Watertight sewer lines	6 Seepage pit

7 Pit privy  
8 Sewage lagoon  
9 Feedyard

10 Livestock pens	14 Abandoned water well
11 Fuel storage	15 Oil well/Gas well
12 Fertilizer storage	16 Other (specify below)
13 Insecticide storage	.....

Direction from well? south

How many feet? 125'

FROM	TO	LITHOLOGIC LOG	FROM	TO	PLUGGING INTERVALS
0	3	top soil	254	256	sandstone grey cemented
3	7	clay yellow brown	256	263	sandstone grey
7	17	shale yellow	263	380	shale grey
17	18	shale red			
18	21	limestone grey			
21	<del>RRR</del> 34	shale grey			
34	51	limestone grey			
51	54	shale grey dark			
54	57	shale black			
57	78	limestone grey			
78	237	shale grey			
<del>XXXX</del>					
237	243	limestone grey			
243	254	sandstone grey shaly			

7 CONTRACTOR'S OR LANDOWNER'S CERTIFICATION: This water well was (1) constructed, (2) reconstructed, or (3) plugged under my jurisdiction and was completed on (mo/day/year) 6-30-04 and this record is true to the best of my knowledge and belief. Kansas

Water Well Contractor's Licence No. 182 This Water Well Record was completed on (mo/day/yr) 6-30-04  
under the business name of Strader Drilling Co., inc. by (signature) [Signature]