

38° 46' 5.199" N
95° 22' S. 661" W

SB-16


WATER WELL PLUGGING RECORD Form WWC-5P KSA 82a-1212 ID NO.

1 LOCATION OF WATER WELL: Fraction SW 1/4 SE 1/4 SW 1/4 SW 1/4 Section Number 1 Township Number T 15 S Range Number 18 E W

County: Douglas
Street/Rural Address of Well Location: if unknown, distance & direction from nearest town or intersection: If at owner's address, check here
Kansas S & N 200 Rd.
1700' West

Global Positioning Systems (GPS) information:
Latitude: 38.7681108 (in decimal degrees)
Longitude: -95.3682392 (in decimal degrees)
Elevation: _____
Horizontal Datum: WGS84, NAD83, NAD27
Collection Method: _____

2 WATER WELL OWNER: Cascade Kansas City Dept. GPS unit (Make/Model): _____
RR#, St. Address, Box #: 601 E. 12th St Digital Map/Photo, Topographic Map, Land Survey
City, State ZIP Code: Kansas City MO. 64104 Accuracy: < 3 m. 3-5 m. 5-15 m. > 15 m

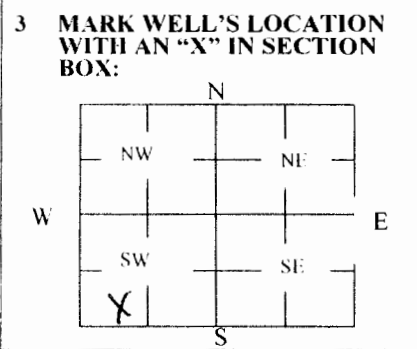

4 DEPTH OF Boreing 24 ft.
WELL'S STATIC WATER LEVEL _____ ft.
WELL WAS USED AS:
 Domestic Public Water Supply Dewatering
 Irrigation Oil Field Water Supply Monitoring
 Feedlot Domestic (Lawn & Garden) Injection Well
 Industrial Air Conditioning Other Soil Boreing
Was a chemical/bacteriological sample submitted to Department? Yes No

5 TYPE OF BLANK CASING USED:
 Steel RMP (SR) Wrought Fiberglass Other (Specify below)
 PVC ABS Asbestos-Cement Concrete Tile
Blank casing diameter _____ in. Was casing pulled? Yes No If yes, how much _____
Casing height above or below land surface _____ in.

6 GROUT PLUG MATERIAL: Neat cement Cement grout Bentonite Other 3/8 Hopslug
Grout Plug Intervals: From 0 ft. to 24 ft., From _____ ft. to _____ ft., From _____ ft. to _____ ft.
What is the nearest source of possible contamination:
 Septic tank Seepage pit Fuel storage Other (specify below)
 Sewer lines Pit privy Fertilizer storage
 Watertight sewer lines Sewage lagoon Insecticide storage
 Lateral lines Feedyard Abandoned water well Direction from well? _____
 Cess pool Livestock pens Oil well/Gas well How many feet? _____

FROM	TO	PLUGGING MATERIALS	FROM	TO	PLUGGING MATERIALS
0	1	Top soil			
1	22	Soft clay - some gravel			
22	24	limestone			

7 CONTRACTOR'S OR LANDOWNER'S CERTIFICATION: This water well was plugged under my jurisdiction and was completed on (mo/day/year) 11/06/2016 and this record is true to the best of my knowledge and belief. Kansas Water Well Contractor's License No. 507. This Water Well Record was completed on (mo/day/year) 11/06/2016 under the business name of Cascade Drilling by (signature) Randy Roubke

Send one white copy to Kansas Department of Health & Environment, Geology Section, 1000 SW Jackson Street, Ste. 420, Topeka, KS 66612-1367. Send one copy to WATER WELL OWNER and retain one for your records.
Visit us at <http://www.kdheks.gov/waterwell/index.html> Telephone 785-296-5524.