

38° 46' S, 225° W  
95° 22' W, 104° W

SB-20

**WATER WELL PLUGGING RECORD Form WWC-5P** KSA 82a-1212 ID NO.


<b>1 LOCATION OF WATER WELL:</b> County: <u>Douglas</u>	Fraction <u>SW 1/4 SE 1/4 SW 1/4</u>	Section Number <u>1</u>	Township Number <u>T 15 S</u>	Range Number <u>18</u> <input checked="" type="checkbox"/> E <input type="checkbox"/> W
--	---	----------------------------	----------------------------------	--

Street/Rural Address of Well Location; if unknown, distance & direction from nearest town or intersection: If at owner's address, check here   
Kansas S & N 200 Rd. 1700' West.

**Global Positioning Systems (GPS) information:**  
Latitude: 38.7681181 (in decimal degrees)  
Longitude: -95.3691956 (in decimal degrees)  
Elevation: \_\_\_\_\_  
Horizontal Datum:  WGS84,  NAD83,  NAD27  
Collection Method: \_\_\_\_\_

**2 WATER WELL OWNER:** Cascade Kansas City Dept.  
RR#, St. Address, Box #: 601 E. 12th St.  
City, State ZIP Code: Kansas City MO. 64104

GPS unit (Make/Model): \_\_\_\_\_  
 Digital Map/Photo,  Topographic Map,  Land Survey  
Accuracy:  < 3 m.  3-5 m.  5-15 m.  > 15 m.

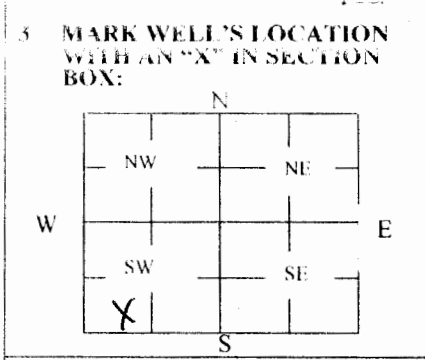

**4 DEPTH OF Borehole, 18' ft.**  
WELL'S STATIC WATER LEVEL \_\_\_\_\_ ft.  
WELL WAS USED AS:  
 Domestic  Public Water Supply  Dewatering  
 Irrigation  Oil Field Water Supply  Monitoring  
 Feedlot  Domestic (Lawn & Garden)  Injection Well  
 Industrial  Air Conditioning  Other Soil Borehole

Was a chemical/bacteriological sample submitted to Department? Yes  No

**5 TYPE OF BLANK CASING USED:**

Steel  RMP (SR)  Wrought  Fiberglass  Other (Specify below)  
 PVC  ABS  Asbestos-Cement  Concrete Tile

Blank casing diameter \_\_\_\_\_ in. Was casing pulled? Yes  No  If yes, how much \_\_\_\_\_  
Casing height above or below land surface \_\_\_\_\_ in.

**6 GROUT PLUG MATERIAL:**  Neat cement  Cement grout  Bentonite  Other 3/8 Hopsburg

Grout Plug Intervals: From 0 ft. to 18 ft., From \_\_\_\_\_ ft. to \_\_\_\_\_ ft., From \_\_\_\_\_ ft. to \_\_\_\_\_ ft.

What is the nearest source of possible contamination:

<input type="checkbox"/> Septic tank	<input type="checkbox"/> Seepage pit	<input type="checkbox"/> Fuel storage	<input type="checkbox"/> Other (specify below)
<input type="checkbox"/> Sewer lines	<input type="checkbox"/> Pit privy	<input type="checkbox"/> Fertilizer storage	
<input type="checkbox"/> Watertight sewer lines	<input type="checkbox"/> Sewage lagoon	<input type="checkbox"/> Insecticide storage	
<input type="checkbox"/> Lateral lines	<input type="checkbox"/> Feedyard	<input type="checkbox"/> Abandoned water well	Direction from well? _____
<input type="checkbox"/> Cess pool	<input type="checkbox"/> Livestock pens	<input type="checkbox"/> Oil well/Gas well	How many feet? _____

FROM	TO	PLUGGING MATERIALS	FROM	TO	PLUGGING MATERIALS
<u>0</u>	<u>1</u>	<u>Top soil</u>			
<u>1</u>	<u>5</u>	<u>Silt-clay - some gravel</u>			
<u>5</u>	<u>8</u>	<u>Limestone</u>			
<u>8</u>	<u>10</u>	<u>Silt-clay - Sand</u>			
<u>10</u>	<u>17</u>	<u>Shale</u>			
<u>17</u>	<u>18</u>	<u>Limestone</u>			

**7 CONTRACTOR'S OR LANDOWNER'S CERTIFICATION:** This water well was plugged under my jurisdiction and was completed on (mo/day/year) 11/08/2016 and this record is true to the best of my knowledge and belief. Kansas Water Well Contractor's License No. 507. This Water Well Record was completed on (mo/day/year) 11/08/2016 under the business name of Cascade Drilling by (signature) Randy Rowland

Send one white copy to Kansas Department of Health & Environment, Geology Section, 1000 SW Jackson Street, Ste. 520, Topeka, KS 66612-1367. Send one copy to WATER WELL OWNER and retain one for your records.  
Visit us at <http://www.kdheks.gov/waterwell/index.html> Telephone 785-296-5524.