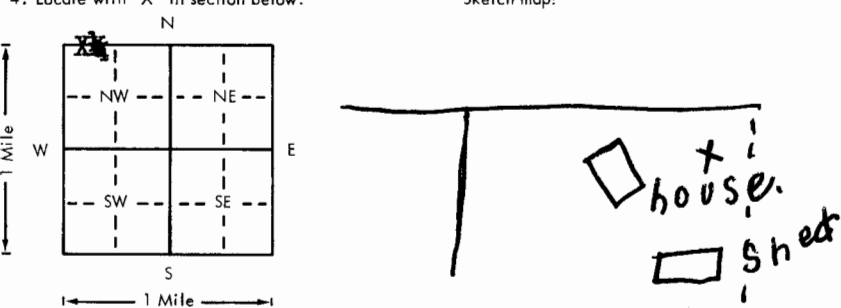


USE TYPEWRITER OR BALL POINT PEN—PRESS FIRMLY, PRINT CLEARLY.

WATER WELL RECORD  
KSA 82a-1201-1215

Kansas Department of Health and Environment—Division of Environment  
(Water well Contractors)  
Topeka, Kansas 66620

1. Location of well:	County <b>Franklin</b>	Fraction <b>NW 1/4 NW 1/4 NW 1/4</b>	Section number <b>23</b>	Township number <b>T 15 S</b>	Range number <b>R 19 E/W</b>																								
2. Distance and direction from nearest town or city: <b>4E 1 1/2 N</b> Street address of well location if in city: <b>Centropolis</b>			3. Owner of well: <b>Mike Bealmer</b> R.R. or street: <b>R.R. 4</b> City, state, zip code: <b>Ottawa Kans</b>																										
4. Locate with "X" in section below: 			6. Bore hole dia. <b>8 1/2</b> in. Completion date <b>5-3-79</b> Well depth <b>70</b> ft. <b>12" to 19'</b>																										
5. Type and color of material			7. <input checked="" type="checkbox"/> Cable tool <input type="checkbox"/> Rotary <input type="checkbox"/> Driven <input type="checkbox"/> Dug <input type="checkbox"/> Hollow rod <input type="checkbox"/> Jetted <input type="checkbox"/> Bored <input type="checkbox"/> Reverse rotary																										
<table border="1" style="width:100%; border-collapse: collapse;"> <thead> <tr> <th style="width:80%;"></th> <th style="width:10%;">From</th> <th style="width:10%;">To</th> </tr> </thead> <tbody> <tr> <td><b>Soil And S Clay</b></td> <td><b>0</b></td> <td><b>12</b></td> </tr> <tr> <td><b>Grey Sand Shale</b></td> <td><b>12</b></td> <td><b>49</b></td> </tr> <tr> <td><b>White lime</b></td> <td><b>49</b></td> <td><b>52</b></td> </tr> <tr> <td><b>Grey Sanded Shale</b></td> <td><b>52</b></td> <td><b>65</b></td> </tr> <tr> <td><b>Lime</b></td> <td><b>65</b></td> <td><b>68</b></td> </tr> <tr> <td><b>Grey Shale</b></td> <td><b>68</b></td> <td><b>70</b></td> </tr> <tr> <td colspan="3" style="text-align:center;">(Use a second sheet if needed)</td> </tr>Use: <input checked="" type="checkbox"/> Domestic <input type="checkbox"/> Public supply <input type="checkbox"/> Industry <input type="checkbox"/> Irrigation <input type="checkbox"/> Air conditioning <input type="checkbox"/> Stock <input type="checkbox"/> Lawn <input type="checkbox"/> Oil field water <input type="checkbox"/> Other		
			9. Casing: Material <b>PVC</b> Height: Above or below Threaded <input type="checkbox"/> Welded <input type="checkbox"/> Surface <b>18</b> in. RMP <input type="checkbox"/> PVC <input checked="" type="checkbox"/> Weight <b>Sch 40</b> lbs./ft. Dia. <b>8</b> in. to <b>19</b> ft. depth Wall Thickness: inches or Dia. <input type="checkbox"/> in. to <input type="checkbox"/> ft. depth gage No. <b>Sch 40</b>																										
			10. Screen: Manufacturer's name <b>NONE</b> Type <input type="checkbox"/> Dia. <input type="checkbox"/> Slot/gauze <input type="checkbox"/> Length <input type="checkbox"/> Set between <input type="checkbox"/> ft. and <input type="checkbox"/> ft. <input type="checkbox"/> ft. and <input type="checkbox"/> ft. Gravel pack? <input type="checkbox"/> Size range of material <input type="checkbox"/>																										
			11. Static water level: <input type="checkbox"/> mo./day/yr. <b>18</b> ft. below land surface Date <b>5-3-19</b>																										
			12. Pumping level below land surfaces: <input type="checkbox"/> ft. after <input type="checkbox"/> hrs. pumping <input type="checkbox"/> g.p.m. <input type="checkbox"/> ft. after <input type="checkbox"/> hrs. pumping <input type="checkbox"/> g.p.m. Estimated maximum yield <b>2</b> g.p.m.																										
			13. Water sample submitted: <input type="checkbox"/> mo./day/yr. <input type="checkbox"/> Yes <input checked="" type="checkbox"/> No Date <input type="checkbox"/>																										
			14. Well head completion: <input checked="" type="checkbox"/> Pitless adapter <b>18</b> Inches above grade																										
			15. Well grouted? <input checked="" type="checkbox"/> With: <input checked="" type="checkbox"/> Neat cement <input type="checkbox"/> Bentonite <input type="checkbox"/> Concrete Depth: From <b>3</b> ft. to <b>19</b> ft.																										
			16. Nearest source of possible contamination: ft. <b>100</b> Direction <b>SW</b> Type <b>Septic</b> Well disinfected upon completion? <input checked="" type="checkbox"/> Yes <input type="checkbox"/> No																										
			17. Pump: <input type="checkbox"/> Not installed Manufacturer's name <b>Red Jacket</b> Model number <b>50 TI9Bc</b> HP <b>1/2</b> Volts <b>230</b> Length of drop pipe <b>60</b> ft. capacity <b>10</b> g.p.m. Type: <input checked="" type="checkbox"/> Submersible <input type="checkbox"/> Turbine <input type="checkbox"/> Jet <input type="checkbox"/> Reciprocating <input type="checkbox"/> Centrifugal <input type="checkbox"/> Other																										
18. Elevation:	19. Remarks: <b>Tis well was drilled before Septic tanks was put in.</b>		20. Water well contractor's certification: This well was drilled under my jurisdiction and this report is true to the best of my knowledge and belief. <b>Edgar Swank Drilling</b> <b>124</b> Business name License No. Address <b>R1 Ottawa Kans.</b> Signed <b>Edgar Swank</b> Date <b>5-19-79</b> Authorized representative																										

T 15 S R 19 E/W Sec 23

Forward the white, blue and pink copies to the Department of Health and Environment

Form WWC-5