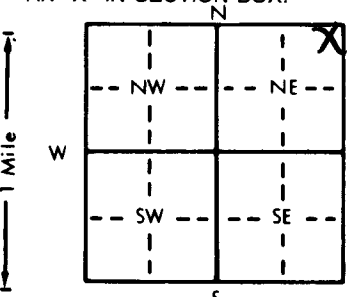


1 LOCATION OF WATER WELL: County: Franklin Fraction: NE 1/4 NE 1/4 NE 1/4 Section Number: 31 Township Number: T 15 S Range Number: R 19 W

Distance and direction from nearest town or city street address of well if located within city?
Least 1/2 South Centropolis

2 WATER WELL OWNER: Gary Griffin
 RR#, St. Address, Box #: RR4
 City, State, ZIP Code: Ottawa, Kan 66067
 Board of Agriculture, Division of Water Resources
 Application Number:

3 LOCATE WELL'S LOCATION WITH AN "X" IN SECTION BOX:

 4 DEPTH OF COMPLETED WELL: 115 ft. ELEVATION:
 Depth(s) Groundwater Encountered 1. 100 ft. 2. ft. 3. ft.
 WELL'S STATIC WATER LEVEL 95 ft. below land surface measured on mo/day/yr May 3 83
 Pump test data: Well water was ft. after hours pumping gpm
 Est. Yield 2 gpm; Well water was ft. after hours pumping gpm
 Bore Hole Diameter: 8 1/4 in. to 50 ft., and 6 1/4 in. to 115 ft.
 WELL WATER TO BE USED AS:
 1 Domestic 3 Feedlot 6 Oil field water supply 9 Dewatering 12 Other (Specify below)
 2 Irrigation 4 Industrial 7 Lawn and garden only 10 Observation well
 Was a chemical/bacteriological sample submitted to Department? Yes.....No.....; If yes, mo/day/yr sample was submitted
 Water Well Disinfected? Yes No

5 TYPE OF BLANK CASING USED:
 1 Steel 3 RMP (SR) 6 Asbestos-Cement 9 Other (specify below)
 2 PVC 4 ABS 7 Fiberglass
 Blank casing diameter 6 1/4 in. to 50 ft., Dia. in. to ft., Dia. in. to ft.
 Casing height above land surface 18 in., weight Sch 40 lbs./ft. Wall thickness or gauge No. Sch 40
 TYPE OF SCREEN OR PERFORATION MATERIAL:
 1 Steel 3 Stainless steel 5 Fiberglass 8 RMP (SR) 11 Other (specify)
 2 Brass 4 Galvanized steel 6 Concrete tile 9 ABS 12 None used (open hole)
 SCREEN OR PERFORATION OPENINGS ARE:
 1 Continuous slot 3 Mill slot 5 Gauzed wrapped 8 Saw cut 11 None (open hole)
 2 Louvered shutter 4 Key punched 6 Wire wrapped 9 Drilled holes
 7 Torch cut 10 Other (specify)
 SCREEN-PERFORATED INTERVALS: From None ft. to ft., From ft. to ft., From ft. to ft.
 GRAVEL PACK INTERVALS: From None ft. to ft., From ft. to ft., From ft. to ft.

6 GROUT MATERIAL: 1 Neat cement 2 Cement grout 3 Bentonite 4 Other
 Grout intervals: From 3 ft. to 50 ft., From ft. to ft., From ft. to ft., From ft. to ft.
 What is the nearest source of possible contamination:
 1 Septic tank 4 Lateral lines 7 Pit privy 10 Livestock pens 14 Abandoned water well
 2 Sewer lines 5 Cess pool 8 Sewage lagoon 11 Fuel storage 15 Oil well/Gas well
 3 Watertight sewer lines 6 Seepage pit 9 Feedyard 12 Fertilizer storage 16 Other (specify below)
 13 Insecticide storage
 Direction from well? South How many feet? 100

FROM	TO	LITHOLOGIC LOG	FROM	TO	LITHOLOGIC LOG
0	10	Soil + Clay			
10	50	Shald			
50	32	Lime			
32	100	gray Sanded Shald			
100	115	gray shald Sand			

7 CONTRACTOR'S OR LANDOWNER'S CERTIFICATION: This water well was (1) constructed, (2) reconstructed, or (3) plugged under my jurisdiction and was completed on (mo/day/year) May 3 83 and this record is true to the best of my knowledge and belief. Kansas Water Well Contractor's License No. 396 This Water Well Record was completed on (mo/day/yr) May 3 83 under the business name of Royce Swank Drilling by (signature) Royce Swank
 INSTRUCTIONS: Use typewriter or ball point pen, PLEASE PRESS FIRMLY and PRINT clearly. Please fill in blanks, underline or circle the correct answers. Send top three copies to Kansas Department of Health and Environment, Division of Environment, Environmental Geology Section, Topeka, KS 66620. Send one to WATER WELL OWNER and retain one for your records.

OFFICE USE ONLY
T
15
R
19
W
SEC. 31
WCA
WCA
WCA
WCA