USE TYPEWRITER OR BALL POINT PEN-PRESS FIRMLY, PRINT CLEARLY.

WATER WELL RECORD
KSA 82a-1201-1215

Kansas Department of Health and Environment-Division of Environment
(Water well Contractors)
Topeka, Kansas 66620

1. Location of well:	County	Fraction	Section number	Township number	Range number
	Franklin	NW 1/4 NW 1/4 NW 1/4	33	T 15 S	R 19 E/W

2. Distance and direction from nearest town or city: 3 W 5 N
Street address of well location if in city: OTTAWA KAN

3. Owner of well: WD Dunlap
R.R. or street:
City, state, zip code: Ottawa Kansas

4. Locate with "X" in section below:

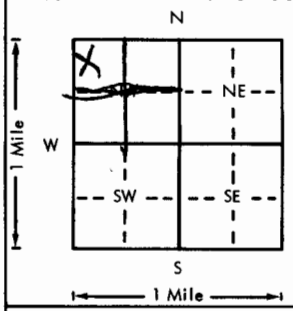

Sketch map:

6. Bore hole dia. 6 in. Completion date 3-10-76
Well depth 155 ft.

7. ✓ Cable tool __ Rotary __ Driven __ Dug
__ Hollow rod __ Jetted __ Bored __ Reverse rotary

8. Use: ✓ Domestic __ Public supply __ Industry
__ Irrigation __ Air conditioning __ Stock
__ Lawn __ Oil field water __ Other

9. Casing: Material _____ Height: Above or below
Threaded ____ Welded ____ Surface 24 in.
RMP ____ PVC ✓ Weight 205 lbs./ft. P2100
Dia. 6 in. to 20 ft. depth Wall Thickness: inches or
Dia. ____ in. to ____ ft. depth gage No. 255

5. Type and color of material	From	To
Soil	0	4
Sandy Shale	4	126
grey Sand	126	155

(Use a second sheet if needed)

10. Screen: Manufacturer's name _____
Type NONE Dia. _____
Slot/gauze _____ Length _____
Set between _____ ft. and _____ ft.
_____ ft. and _____ ft.
Gravel pack? ____ Size range of material _____

11. Static water level: mo./day/yr.
100 ft. below land surface Date 3/76

12. Pumping level below land surfaces:
____ ft. after ____ hrs. pumping ____ g.p.m.
____ ft. after ____ hrs. pumping ____ g.p.m.
Estimated maximum yield 10 g.p.m.

13. Water sample submitted: mo./day/yr.
__ Yes ✓ No Date _____

14. Well head completion:
✓ Pitless adapter 24 Inches above grade

15. Well grouted? ✓
With: ✓ Neat cement __ Bentonite __ Concrete
Depth: From 0 ft. to 20 ft.

16. Nearest source of possible contamination:
ft. 100 Direction S.E Type Septic
Well disinfected upon completion? ✓ Yes __ No

17. Pump: __ Not installed
Manufacturer's name RED JACKET
Model number 50N19BL HP 1/2 Volts 220
Length of drop pipe 143 ft. capacity 10 g.p.m.
Type:
✓ Submersible __ Turbine
__ Jet __ Reciprocating
__ Centrifugal __ Other

18. Elevation:

Topography:
__ Hill
__ Slope
✓ Upland
__ Valley

19. Remarks:
Cement Plat form is to be poured by Customer as Soon as ground Settles

20. Water well contractor's certification:
This well was drilled under my jurisdiction and this report is true to the best of my knowledge and belief.
EDGAR SWANK DRILLING
Business name License No. 124
Address RR 4 OTTAWA K
Signed Edgar Swank Date 5-30-76
Authorized representative

T 15 R 19 E/W Sec 33 1/4 1/4 1/4 NW NW NW

Forward the white, blue and pink copies to the Department of Health and Environment

Form WWC-5

MI-1023