


1 LOCATION OF WATER WELL: Fraction SW 1/4 SW 1/4 SE 1/4 Section Number 8 Township Number T 15 S Range Number R 17 E
 County: Douglas

Distance and direction from nearest town or city street address of well if located within city?
960 N 109 Rd Douglas County

2 WATER WELL OWNER: Richard Johanning
 RR#, St. Address, Box # : 105 Dearborn St.
 City, State, ZIP Code : Baldwin City Ks. 66006
 Board of Agriculture, Division of Water Resources
 Application Number:

3 LOCATE WELL'S LOCATION WITH AN "X" IN SECTION BOX: 4 DEPTH OF COMPLETED WELL 155 ft. ELEVATION: 104-154 ft.

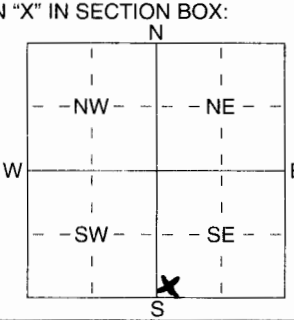

Depth(s) Groundwater Encountered: 1 92 ft. 2 104-154 ft. 3 _____ ft.
 WELL'S STATIC WATER LEVEL: 92 ft. below land surface measured on mo/day/yr _____
 Pump test data: Well water was _____ ft. after _____ hours pumping _____ gpm
 Est. Yield: 14 gpm: Well water was _____ ft. after _____ hours pumping _____ gpm
 WELL WATER TO BE USED AS:
 Domestic 3 Feedlot 6 Oil field water supply 9 Dewatering 12 Other (Specify below)
 2 Irrigation 4 Industrial 7 Domestic (lawn & garden) 10 Monitoring well _____
 Was a chemical/bacteriological sample submitted to Department? Yes _____ No X; If yes, mo/day/yr sample was submitted
 Water Well Disinfected? Yes X No _____

5 TYPE OF BLANK CASING USED:
 1 Steel 3 RMP (SR) 5 Wrought iron 8 Concrete tile CASING JOINTS: Glued X Clamped _____
 2 PVC 4 ABS 6 Asbestos-Cement 9 Other (specify below) Welded _____
 7 Fiberglass Threaded _____

Blank casing diameter 5 in. to 145 ft., Dia. _____ in. to _____ ft., Dia. _____ in. to _____ ft.
 Casing height above land surface 30 in., weight SDR 21 200 PSI lbs./ft. Wall thickness or gauge No. _____

TYPE OF SCREEN OR PERFORATION MATERIAL:
 1 Steel 3 Stainless Steel 5 Fiberglass 8 RMP (SR) 10 Asbestos-Cement
 2 Brass 4 Galvanized Steel 6 Concrete tile 9 ABS 11 Other (Specify) _____
 12 None used (open hole)

SCREEN OR PERFORATION OPENINGS ARE:
 1 Continuous slot 3 Mill slot 5 Guazed wrapped 8 Saw cut 11 None (open hole)
 2 Louvered shutter 4 Key punched 6 Wire wrapped 9 Drilled holes
 7 Torch cut 10 Other (specify) _____ ft.

SCREEN-PERFORATED INTERVALS: From 145 ft. to 155 ft., From _____ ft. to _____ ft.
 GRAVEL PACK INTERVALS: From 155 ft. to 92 ft., From 72 ft. to 40 ft.
 From _____ ft. to _____ ft., From _____ ft. to _____ ft.

6 GROUT MATERIAL: 1 Neat cement 2 Cement grout 3 Bentonite 4 Other _____
 Grout Intervals: From 92 ft. to 72 ft., From 40 ft. to 0 ft., From _____ ft. to _____ ft.

What is the nearest source of possible contamination:
 1 Septic tank 4 Lateral lines 7 Pit privy 10 Livestock pens 14 Abandoned water well
 2 Sewer lines 5 Cess pool 8 Sewage lagoon 11 Fuel storage 15 Oil well/Gas well
 3 Watertight sewer lines 6 Seepage pit 9 Feedyard 12 Fertilizer storage 16 Other (specify below)
 13 Insecticide storage _____
 Direction from well? W NW How many feet? 150+

FROM	TO	LITHOLOGIC LOG	FROM	TO	PLUGGING INTERVALS
0	3	So. 1			
3	7	Lime			
7	9	yellow shale			
9	14	grey shale			
14	28	Black shale			
28	32	Lime			
32	64	Shale			
64	66	Sandstone			
66	71	Shale			
71	97	Sandstone			
97	104	Shale			
104	154	Sandstone			
154	155	Limestone			

7 CONTRACTOR'S OR LANDOWNER'S CERTIFICATION: This water well was (1) constructed, (2) reconstructed, or (3) plugged under my jurisdiction and was completed on (mo/day/year) 7-27-04 and this record is true to the best of my knowledge and belief. Kansas Water Well Contractor's Licence No. 561 This Water Well Record was completed on (mo/day/yr) 7-29-04 under the business name of Evans Energy Dev. Inc. by (signature) Scott G. Evans