

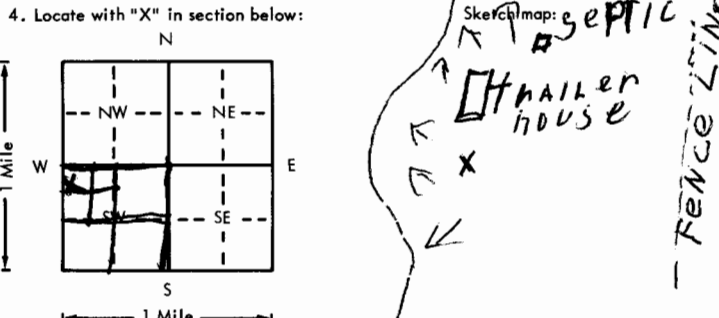
USE TYPEWRITER OR BALL
POINT PEN-PRESS FIRMLY
PRINT CLEARLY.

WATER WELL RECORD
KSA 82a-1201-1215

Kansas Department of Health and
Environment-Division of Environment
(Water well Contractors)
Topeka, Kansas 66620

95.33530 38.74500

SE NE NW SE ?

1. Location of well:		County DOUGLAS	Fraction NW 1/4 NW 1/4 SW 1/4	Section number 18	Township number T 15 S	Range number R 19 E
2. Distance and direction from nearest town or city:		3 MI S 1 MI W		3. Owner of well: JIM DYER 594-3475		
Street address of well location if in city:		WORDEN HALL		City, state, zip code: BALDWIN KANSAS		
4. Locate with "X" in section below:				6. Bore hole dia. 6 1/2 in. Completion date 12-3-75 Well depth 150 ft. 8 1/2 " to 10 "		
5. Type and color of material		From		To		7. ☒ Cable tool ☐ Rotary ☐ Driven ☐ Dug ☐ Hollow rod ☐ Jetted ☐ Bored ☐ Reverse rotary
LOOSE ROCK		0		4		8. Use: ☒ Domestic ☐ Public supply ☐ Industry ☐ Irrigation ☐ Air conditioning ☐ Stock ☐ Lawn ☐ Oil field water ☐ Other
CLAY		4		6		9. Casing: Material PLASTIC Height: Above or below Threaded ☐ Welded ☐ Surface 18 in. MHC RMP ☐ PVC ☒ Weight 10 lbs./ft. 7 Dia. 5 in. to 150 ft. depth Wall Thickness: Inches or Dia. 5 in. to 150 ft. depth gage No. 180 Sch 40
GREY SHALE		6		20		10. Screen: Manufacturer's name CROWN LINE PVC Type PVC Dia. 5 Slot gauze 1/16 Length 20 Set between 130 ft. and 150 ft. Gravel pack? NO Size range of material
LIME		20		24		11. Static water level: 50 ft. below land surface Date 12-3-75 mo./day/yr.
GREY SHALE		24		115		12. Pumping level below land surfaces: ft. after hrs. pumping g.p.m. ft. after hrs. pumping g.p.m. Estimated maximum yield 4 g.p.m.
GREY SANDED SHALE		115		117		13. Water sample submitted: NO mo./day/yr.
SHALE		117		137		14. Well head completion: PUMP HOUSE Pitless adapter NO Inches above grade
GREY SAND		137		150		15. Well grouted? ☒ With: ☒ Neat cement ☐ Bentonite ☐ Concrete Depth: From 0 ft. to 22 ft.
(Use a second sheet if needed)						16. Nearest source of possible contamination: ft. 105 Direction NE Type SEPTIC Well disinfected upon completion? ☒ Yes ☐ No
						17. Pump: Not installed Manufacturer's name Red JACKET Model number SS6N1906 Volts 230 Length of drop pipe 140 ft. capacity 10 g.p.m. Type: ☒ Submersible ☐ Turbine ☐ Jet ☐ Reciprocating ☐ Centrifugal ☐ Other
18. Elevation:	19. Remarks:		20. Water well contractor's certification: This well was drilled under my jurisdiction and this report is true to the best of my knowledge and belief. EDGAR SWANK 124 Business name B4 OTIANA KANS. License No. Address Edgar Swank Date 1-3-76 Signed Edgar Swank Authorized representative			

Forward the white, blue and pink copies to the Department of Health and Environment

Form WWC-5