


1 LOCATION OF WATER WELL: County: Franklin Fraction: SW 1/4 SE 1/4 SW 1/4 Section Number: 33 Township Number: T 15 S Range Number: R 19 E

Distance and direction from nearest town or city street address of well located within city? 2131 Shawnee Road Ottawa, KS. 66067

2 WATER WELL OWNER: Jeff Weien  
 RR#, St. Address, Box #: 1040 N. Hickory  
 City, State, ZIP Code: OTTAWA KS, 66067  
 Board of Agriculture, Division of Water Resources  
 Application Number:

3 LOCATE WELL'S LOCATION WITH AN "X" IN SECTION BOX:

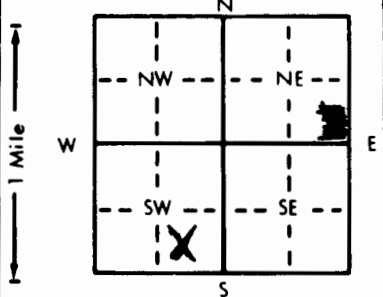

4 DEPTH OF COMPLETED WELL: 99 ft. ELEVATION: 8-10-94

Depth(s) Groundwater Encountered: 1. 60-98 ft. 2. 60-98 ft. 3. 60-98 ft.  
 WELL'S STATIC WATER LEVEL: 44 ft. below land surface measured on mo/day/yr  
 Pump test data: Well water was 10 gpm. Well water was 77/8 ft. after 99 hours pumping  
 Est. Yield: 10 gpm. Well water was 77/8 ft. after 99 hours pumping  
 Bore Hole Diameter: 8 3/4 in. to 20 ft., and 7 7/8 in. to 99 ft.  
 WELL WATER TO BE USED AS:  
 1 Domestic     3 Feedlot     6 Oil field water supply     9 Dewatering     12 Other (Specify below)  
 2 Irrigation     4 Industrial     7 Lawn and garden only     10 Monitoring well  
 Was a chemical/bacteriological sample submitted to Department? Yes    No   ; If yes, mo/day/yr sample was submitted     
 Water Well Disinfected? Yes    No   

5 TYPE OF BLANK CASING USED:  
 1 Steel     3 RMP (SR)     5 Wrought iron     8 Concrete tile    CASING JOINTS: Glued    Clamped     
 2 PVC     4 ABS     6 Asbestos-Cement     9 Other (specify below)    Welded     
 3 Mill slot     7 Fiberglass    Threaded     
 Blank casing diameter: 5 1/2 in. to 8 1/2 ft., Dia.    in. to    ft., Dia.    in. to    ft.  
 Casing height above land surface: 30 in., weight    lbs./ft. Wall thickness or gauge No. 20.0H

TYPE OF SCREEN OR PERFORATION MATERIAL:  
 1 Steel     3 Stainless steel     5 Fiberglass     7 PVC     10 Asbestos-cement  
 2 Brass     4 Galvanized steel     6 Concrete tile     8 RMP (SR)     11 Other (specify)     
 12 None used (open hole)

SCREEN OR PERFORATION OPENINGS ARE:  
 1 Continuous slot     3 Mill slot     5 Gauzed wrapped     8 Saw cut     11 None (open hole)  
 2 Louvered shutter     4 Key punched     6 Wire wrapped     9 Drilled holes  
 7 Torch cut     10 Other (specify)   

SCREEN-PERFORATED INTERVALS: From 89 ft. to 99 ft., From    ft. to    ft., From    ft. to    ft.  
 GRAVEL PACK INTERVALS: From 99 ft. to 20 ft., From    ft. to    ft., From    ft. to    ft.

6 GROUT MATERIAL:  1 Neat cement     2 Cement grout     3 Bentonite     4 Other     
 Grout Intervals: From 20 ft. to 0 ft., From    ft. to    ft., From    ft. to    ft., From    ft. to    ft.

What is the nearest source of possible contamination: NONE AT THE TIME  
 1 Septic tank     4 Lateral lines     7 Pit privy     10 Livestock pens     14 Abandoned water well  
 2 Sewer lines     5 Cess pool     8 Sewage lagoon     11 Fuel storage     15 Oil well/Gas well  
 3 Watertight sewer lines     6 Seepage pit     9 Feedyard     12 Fertilizer storage     16 Other (specify below)     
 13 Insecticide storage

Direction from well? How many feet?

FROM	TO	LITHOLOGIC LOG	FROM	TO	PLUGGING INTERVALS
0	3	Soil			
3	14	Yellow Sand + Clay			
14	26	Shale			
26	36	Yellow Sand			
36	38	Shale			
38	60	Brownish Yellow Sand			
60	98	Sand, grey, large grained			
98	99	Lime			

7 CONTRACTOR'S OR LANDOWNER'S CERTIFICATION: This water well was (1)  constructed (2) reconstructed, or (3) plugged under my jurisdiction and was completed on (mo/day/year) 8-10-94 and this record is true to the best of my knowledge and belief. Kansas Water Well Contractor's License No. 561 This Water Well Record was completed on (mo/day/yr) 8-14-94 under the business name of EVANS Energy Dev. Inc. by (signature) [Signature]